


D-005A

EFFLUENT WATER BALANCE TANK

CAPACITY m3 (BRLS) : 16,711 (105111)
ID mm (ft.-in) : 46500 (152'-7")
HEIGHT mm (ft.-in) : 11400 (37'-5")
OP PRESS /DES PRESS MMWG (N WG) : 50~127/254/-38 (2~5/10/-1.5)
OP TEMP/DESIGN TEMP °C (°F) : 15~55/93/-3 (59~131/200/27)
UTC NO. :
TRIM NO. : DT-D005A-Q15B/C15B1/Q35B/C35B1

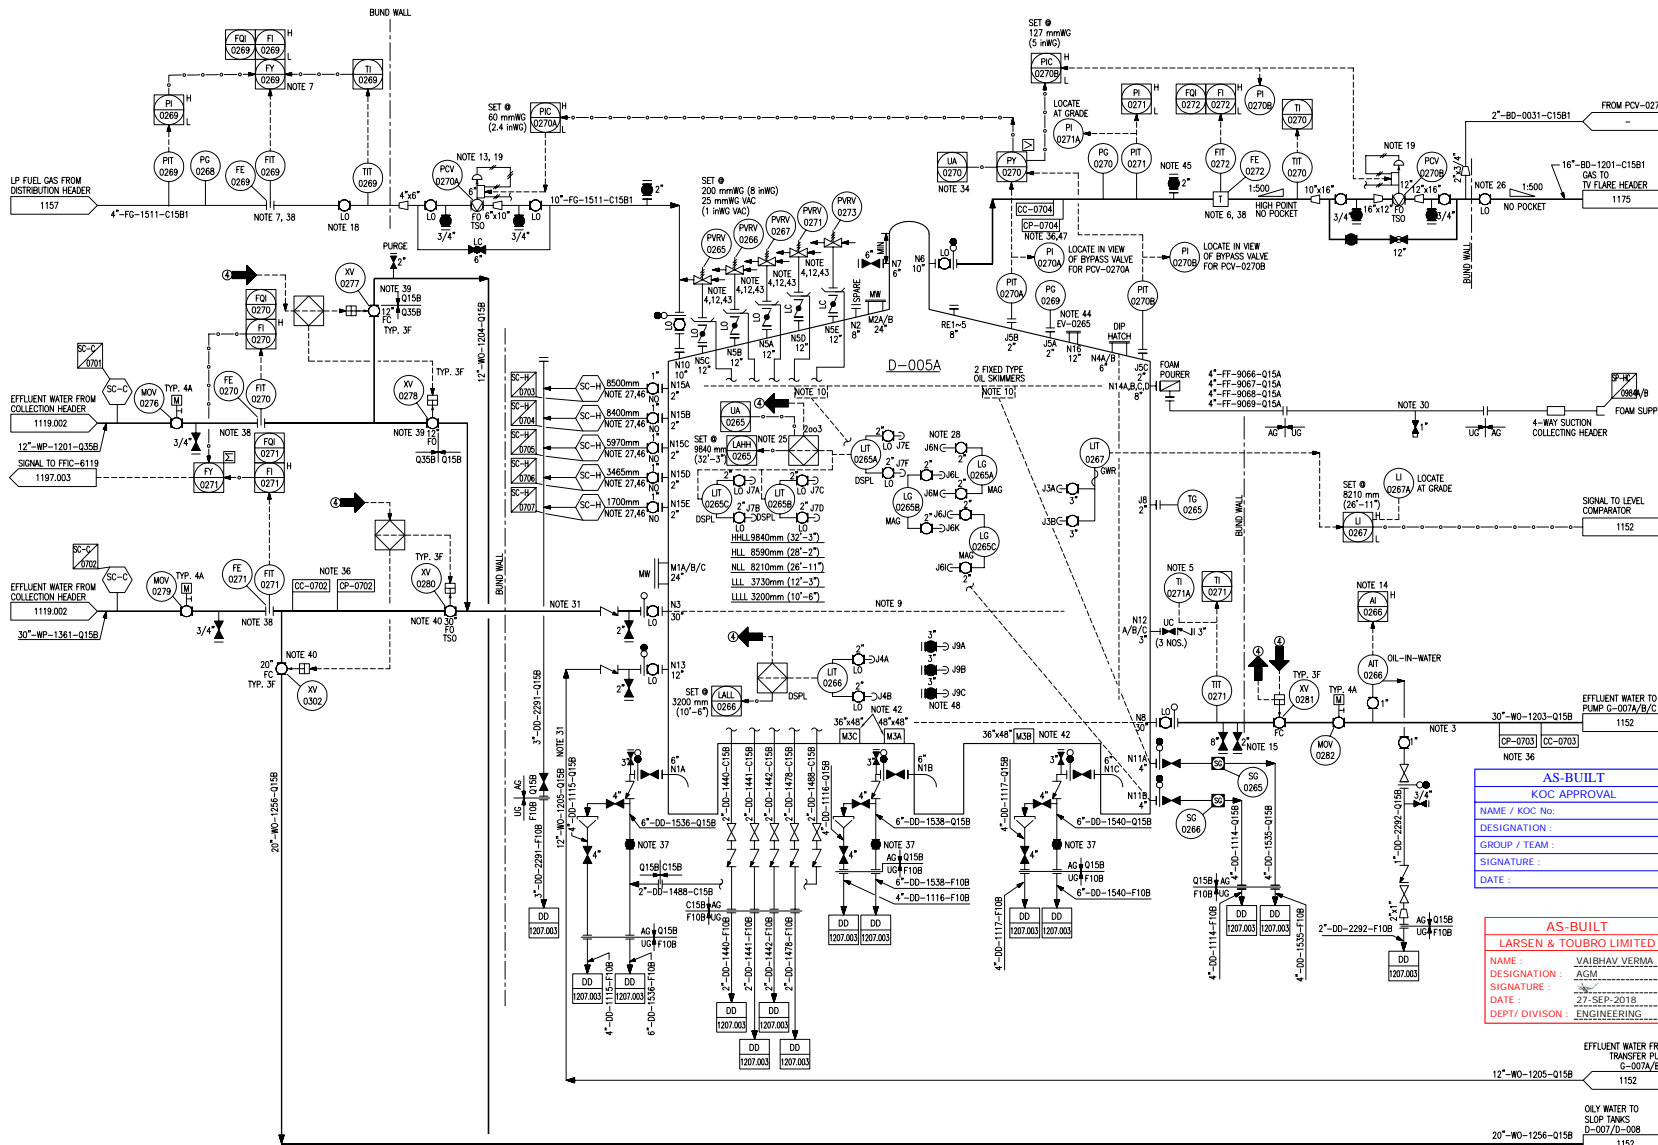

NOTES: (CONTD.)

43. ONLY ONE PVRV TO BE REMOVED AT A TIME FOR MAINTENANCE/INSPECTION, WHEN TANK IS IN SERVICE.
44. EMERGENCY VENT VALVE ONE IS INSTALLED & ONE IS WAREHOUSE SPARE.
45. PURGE CONNECTION IS PROVIDED ON TANK VAPOR OUTLET LINE.
46. TROCK ELEVATIONS ARE ALIGNED WITH TANK LEVEL.
47. ONE ADDITIONAL INTERNAL CORROSION MONITORING PROBE SHALL BE INSTALLED AT THE TOP AT 120° CLOCK POSITION.
48. JMW/B/C SPARE NOZZLE ELEVATIONS:-
J9A : 10210 mm FROM THE BOTTOM OF THE TANK
J9B : 6530 mm FROM THE BOTTOM OF THE TANK
J9C : 5841 mm FROM THE BOTTOM OF THE TANK

GENERAL NOTES:

- A. FOR STANDARD SYMBOLS AND NOMENCLATURE SEE DRAWINGS 50489-530-020-PID-1104.001 & 002.
- B. ALL EQUIPMENT NUMBERS SHOWN ON THIS P&ID ARE PRECEDED BY 530-.
- C. ALL INSTRUMENT NUMBERS SHOWN ON THIS P&ID ARE PRECEDED BY 030-.
- D. FOR TYPICAL INSTRUMENT CONNECTION SBDV, XV, MOV & ESDV DETAILS SEE DRAWINGS 50489-530-020-PID-1106.002, 003, 004, 005, 006 & 007.
- E. FOR MISCELLANEOUS PIPING TYPICAL VALVING, DRAINAGE & GENERAL ARRANGEMENT OF LEVEL INSTRUMENTS, PUMPS, STRAINERS & CONTROL VALVES SEE DRAWINGS 50489-530-020-PID-1108.001 TO 1108.010.
- F. DRAWING NUMBERS SHOWN IN P&ID CONTINUATION BOXES ARE ABBREVIATED SHOWING DRAWING SEQUENTIAL NUMBERS ONLY. THE FULL FORM OF THE DRAWING NUMBER IS 50489-530-020-PID-XXXX.SHT.NO.
- G. FOR MATERIAL SELECTION DIAGRAM SEE DRAWINGS 50489-530-020-MSD-1001.001 TO 1001.023.
- H. DETAIL NUMBERING FOR CL, CS, CC & CP SEE DRAWING 50489-530-020-PID-1108.003.
- I. PAINTING & COATING ARE IN ACCORDANCE WITH KOC-P-001.
- J. LOW POINT DRAIN & HIGH POINT VENT ARE INDICATED IN P&ID.
- K. FOR CAUSE & EFFECT REFER DOC. NO. 50489-530-020-PHL-1009.
- L. FOR ALARM VALUES REFER DOC. NO. 50489-530-020-SUM-1006.

NOTES:

1. DELETED.
2. FOR CHEMICAL INJECTION NOZZLE DETAIL SEE STANDARD DWG. 50489-530-020-PID-1108.001.
3. PUMP SUCTION AND DISCHARGE MANIFOLD AND HEADER ARE SIZED FOR 320,000 BWP.
4. DRIP PAN FOR PVRV PIPE IS CONNECTED TO TANK BASE.
5. TI-0271 LOCATED CLOSE TO D-005A.
6. CONSIDERING VERY LOW PRESSURE DROP AVAILABILITY, PRESENCE OF DROPLETS CARRIED OVER INTO THE GAS STREAMS AND THE REQUIRED ACCURACY, INSERTION TYPE THERMAL MASS FLOW METER IS USED.
7. FY PROVIDES PRESSURE AND TEMPERATURE COMPENSATION FOR FOI.
8. DELETED.
9. DISTRIBUTOR IS PROVIDED FOR UNIFORM DISTRIBUTION OF EFFLUENT WATER OVER CROSS SECTIONAL AREA OF TANK.
10. FIXED TYPE OF OIL COLLECTOR PIPE SYSTEM IS PROVIDED IN BETWEEN HLL & NLL.
11. DELETED.
12. PVRV IS N42 WITH FLAME ARRESTOR & AS PER KOC-MP-007 & 9.6.
13. THE CAPACITY OF CONTROL VALVES IS NOT MORE THAN PVRV OUBREATHING CAPACITY. 5405.36 Nm3/hr (4.84 MMSCFD).
14. OIL IN WATER ANALYSERS PROVIDED.
15. MOBILE PUMP CONNECTION.
16. LOCATE AT GRADE.
17. LOCATE ON THE ROOF OF TANK.
18. 16,17,20,21,22,23,24. DELETED.
19. 2 OUT OF 3 VOTING.
20. THE ISOLATION VALVE FOR TANK VAPOR LOCATED NEAR TO TV FLARE HEADER.
21. FOR SAMPLE NOZZLE DETAIL SEE STANDARD DWG. 50489-530-020-PID-1108.001.
22. MULTIPLE LEVEL GAUGES ARE PROVIDED TO COVER ALL OPERATING RANGES.
23. DELETED.
24. FOR DETAILS OF TANK AREA FIRE PROTECTION SYSTEMS & PIT LOCATION REFER TO DRAWING 50489-530-000-PID-1133.
25. 31,32,33. DELETED.
26. DERIVATION OF PIT-0270A/B OUTPUT OF 5% INITIATES ALARM.
27. DELETED.
28. FOR CORROSION MONITORING STATIONS (CMS):-
(a) CMS ARE INSTALLED AS PER KOC-MP-035.
(b) PROPER ACCESS PIT OR PLATFORM ARE PROVIDED FOR RETRIEVAL OF COUPON/PROBE.
(c) MATERIAL FOR CMS ARE PROVIDED FROM KOC APPROVED VENDOR LIST.
(d) CMS ARE LOCATED IN BOTTOM & 6 O'CLOCK POSITION.
(e) TAG NUMBERING OF CMS IS AS PER APPENDIX C OF KOC-MP-035.
29. ENSURE THAT LOCATION OF BALL VALVES PROVIDED ON THE DRAIN LINES CLOSE TO THE DIVERTING DRAIN TO THE FURNEL.
30. STRAIGHT LENGTH REQUIRED
(a) FOR ORIFICE FLOW METER : 20D UPSTREAM & 5D DOWNSTREAM
(b) FOR THERMAL MASS FLOW METER : 10D UPSTREAM & 5D DOWNSTREAM
31. IN CASE OF HIGH-LEVEL (LHH-0265) IN THE EFFLUENT WATER BALANCE TANK, EFFLUENT WATER FROM UPSTREAM OF TANK IS AUTOMATICALLY ROUTED TO SLOP TANK BY OPENING OF XV-0271 & CLOSING OF XV-0278.
32. IN CASE OF HIGH-HIGH LEVEL (LHH-0265) IN THE EFFLUENT WATER BALANCE TANK, EFFLUENT WATER FROM UPSTREAM OF TANK IS AUTOMATICALLY ROUTED TO SLOP TANK BY OPENING OF XV-0302 & CLOSING OF XV-0280.
33. DELETED.
34. DELETED.
35. CLEAN OUT DOOR.

AS-BUILT
KOC APPROVAL
NAME / KOC No. :
DESIGNATION :
GROUP / TEAM :
SIGNATURE :
DATE :
DEPT / DIVISION :

AS-BUILT
LARSEN & TOUBRO LIMITED
NAME : VAIBHAV VERMA
DESIGNATION : AGM
SIGNATURE :
DATE : 27-SEP-2018
DEPT / DIVISION : ENGINEERING

REV.	DESCRIPTION	DRAWN	CHECKED	HOD	PEM	DATE
Z1	RE-ISSUED FOR AS-BUILT	BAK/SSI	AKG	SRA	RAK	27.09.18
Z0	ISSUED FOR AS-BUILT	BAK/SSI	AKG	SRA	RAK	28.08.18
O1	ISSUED FOR CONSTRUCTION	BAK/SSI	AKG	SRA	RAK	02.11.16
O	ISSUED FOR CONSTRUCTION	HSR/PRS	AKG	SRA	RAK	24.05.16
C	ISSUED INCORPORATED CLIENT COMMENTS	HSR/VSA	AKG	SRA	RAK	19.04.16
D	ISSUED INCORPORATED CLIENT COMMENTS	BAK/VSA	AKG	SRA	RAK	14.10.15
OC	ISSUED INCORPORATED CLIENT COMMENTS	BAK/VSA	AKG	SRA	RAK	30.05.15
B	ISSUED INCORPORATED CLIENT COMMENTS	JSI/VSA	AKG	SRA	RAK	19.02.15
A	ISSUED FOR APPROVAL	BAK/VSA	AKG	SRA	RAK	05.12.14

KUWAIT OIL CO. K. S. C. **شركة النفط الكويت ك. س. ك.**

CONTRACTOR DETAILS:-	
	LARSEN & TOUBRO LIMITED FARIDABAD
PROJECT TITLE:-	
NEW GATHERING CENTRE GC-30 IN NORTH KUWAIT	
DOCUMENT TITLE:-	
PIPING & INSTRUMENTATION DIAGRAM EFFLUENT WATER BALANCE TANK D-005A	
PROJECT NO.	DRAWING NO.
EF1902	Z1
CONTRACTOR DRG. NO.	REV. KOC DRG. NO.
50489-530-020-PID-1151.001	Z1
SHEET NO. 1 OF 2	SHEET NO.
EF1902-530-DCO-PID-0151.001	A4
COMPANY DRG. NO.	REV.
50489-530-DCO-PID-0151.001	
SHEET NO.	