


PU-1240
DF POWER UNIT
RATING : 100 KVA, 480 VAC, 50 HZ, 3PHASE
PRIMARY CURRENT : 138AAC
SECONDARY VOLTAGE : 34 KV DC PEAK.

TR-1240
DUAL FREQUENCY AUTO TRANSFORMER
RATING : 136 KVA, 440 VAC, 50 HZ, 3PHASE
PRIMARY CURRENT : 179AAC
SECONDARY CURRENT : 164AAC
SECONDARY VOLTAGE : 480VAC

CP-1240
DF LRC-II PANEL
RATING : 110VAC, 50HZ, 1PHASE

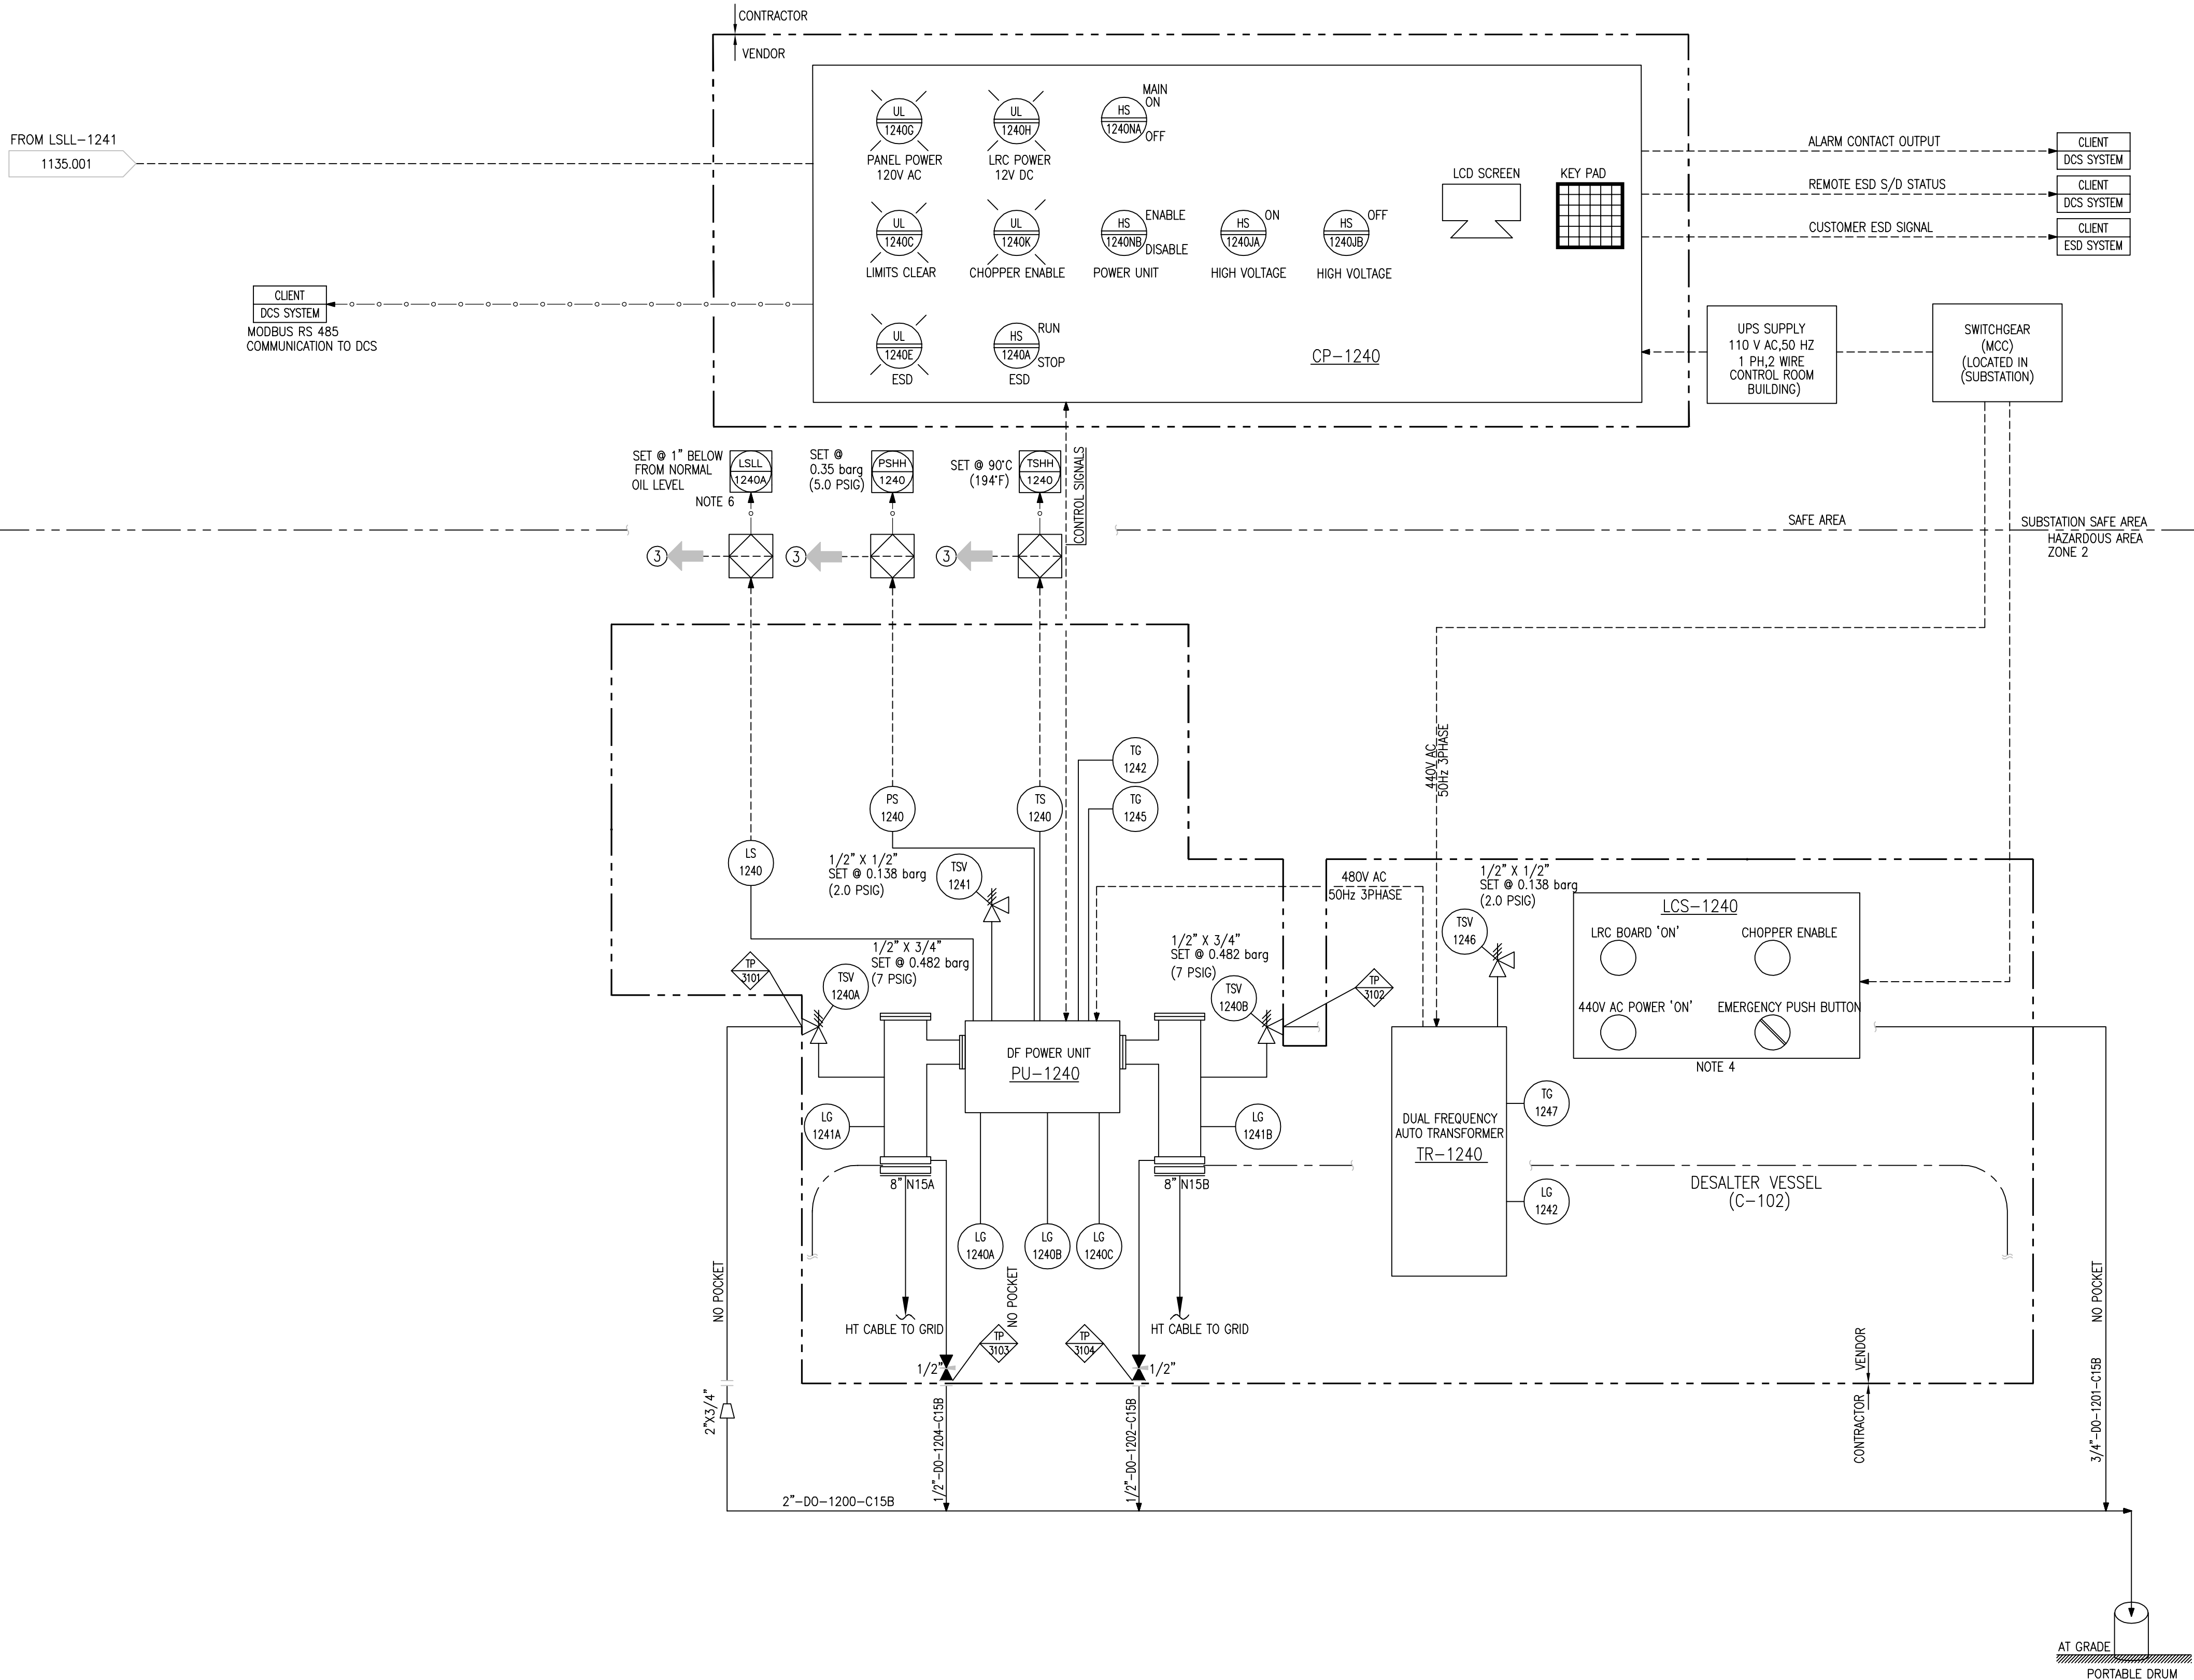

GENERAL NOTES:

- FOR STANDARD SYMBOLS AND NOMENCLATURE SEE DRAWINGS 50489-530-020-PID-1104.001 & .002.
- ALL EQUIPMENT NUMBERS SHOWN ON THIS P&ID ARE PRECEDED BY 530--.
- ALL INSTRUMENT NUMBERS SHOWN ON THIS P&ID ARE PRECEDED BY 030--.
- FOR TYPICAL INSTRUMENT CONNECTION SBDV, XV, MOV & ESDV DETAILS SEE DRAWINGS 50489-530-020-PID-1106.001, .002, .003, .004, .005, .006 & .007.
- FOR MISCELLANEOUS PIPING TYPICAL VALVING, DRAINAGE & GENERAL ARRANGEMENT OF LEVEL INSTRUMENTS, PUMPS, STRAINERS & CONTROL VALVES SEE DRAWINGS 50489-530-020-PID-1108.001 TO 1108.010.
- DRAWING NUMBERS SHOWN IN P&ID CONTINUATION BOXES ARE ABBREVIATED SHOWING DRAWING SEQUENTIAL NUMBERS ONLY. THE FULL FORM OF THE DRAWING NUMBER IS 50489-530-020-PID-XXXX.SHT.NO.
- FOR MATERIAL SELECTION DIAGRAM SEE DRAWINGS 50489-530-020-MSD-1001.001 TO 1023.
- DETAIL NUMBERING FOR CI, SC, CC & CP SEE DRAWING 50489-530-020-PID-1108.003.
- PAINTING & COATING ARE IN ACCORDANCE WITH KOC-P-001.
- LOW POINT DRAIN & HIGH POINT VENT ARE INDICATED IN P&ID.
- FOR CAUSE & EFFECT REFER DOC. NO. 50489-530-020-PHL-1009.
- FOR ALARM VALUES REFER DOC. NO. 50489-530-020-SUM-1006.

NOTES:

- DELETED
- EACH DUAL FREQUENCY DESALTER IS PROVIDED WITH LCS (LOCAL CONTROL STATION) IN THE FIELD FOR FOLLOWING:
 - LRC BOARD 'ON' (INDICATION)
 - CHOPPER ENABLE (INDICATION)
 - 440V AC POWER 'ON' (INDICATION)
 - EMERGENCY PUSH BUTTON.
- TSV MOUNTED ON THE POWER UNIT IS PIPED TO AN OPEN DRAIN.
- THERE ARE THREE INTERNAL LIQUID LEVEL SWITCHES IN POWER UNIT (ONE IN EACH TANK) WHICH ARE WIRED IN SERIES TO A COMMON TERMINAL IN THE JUNCTION BOX.
- VENDOR REFERENCE DOCUMENT/DRAWING IS AS FOLLOWS.
DESALTER P&ID-(50489-530-020-07226-PID-V002).
POWER UNIT DATA SHEET-(50489-530-070-07226-DAT-V001).
AUTO TRANSFORMER DATA SHEET-(50489-530-070-07226-DAT-V002).
INSTRUMENT CABLE BLOCK DIAGRAM-(50489-530-080-07226-BLD-V001).
CAUSE & EFFECT DIAGRAM-(50489-530-020-07226-CAE-V001).
- DELETED
- TYPE OF FLUID IN TRANSFORMER: CROSS 206 MINERAL OIL (NON-PCB).
- LIST OF ABBREVIATION
DF : DUAL FREQUENCY
HT : HIGH TENSION
CP : DF LRC II PANEL
LCS: LOCAL CONTROL SWITCH
LRC: LOAD RESPONSIVE CONTROLLER
TR : DF AUTO TRANSFORMER
PCB : POLYCHLORINATED & BI-PHENYL
PU : POWER UNIT

AS-BUILT	
KOC APPROVAL	
NAME / KOC No:	
DESIGNATION :	
GROUP / TEAM :	
SIGNATURE :	
DATE :	

AS-BUILT	
LARSEN & TOUBRO LIMITED	
NAME :	VAIBHAV VERMA
DESIGNATION :	AGM
SIGNATURE :	
DATE :	05-Sep-2018
DEPT/ DIVISION :	ENGINEERING

ZO	ISSUED FOR AS-BUILT	HSB/SSI	AKG	SRA	DER	05.09.18
01	ISSUED FOR CONSTRUCTION	HSB/SSI	AKG	SRA	DER	27.12.16
0	ISSUED FOR CONSTRUCTION	PAK/PRS	AKG	SRA	RAK	09.06.16
B	ISSUED INCORPORATED CLIENT COMMENTS	PAK/ABY	AKG	SRA	RAK	14.04.16
A	ISSUED FOR APPROVAL	JSI/VSA	AKG	SRA	RAK	09.09.15
REV.	DESCRIPTION	DRAWN	CHECKED	HOD	PEM	DATE
				APPRD.		

CONTRACTOR REVISION

KUWAIT OIL CO. K. S. C. شركة نفط الكويت ش.م.ك. A Subsidiary of Kuwait Petroleum Corporation	
CONTRACTOR DETAILS:- LARSEN & TOUBRO LIMITED FARIDABAD	
PROJECT TITLE:- NEW GATHERING CENTRE GC-30 IN NORTH KUWAIT	
DOCUMENT TITLE:- PIPING & INSTRUMENTATION DIAGRAM FIRST STAGE DESALTER POWER UNIT TRAIN-A (530-C-102)	
PROJECT NO.	DRAWING NO.
CONTRACTOR DRG. NO.	REV. KOC DRG. NO.
50489-530-020-PID-1135.003	ZO
SHEET NO. 3 OF 4	SHEET NO.
COMPANY DRG. NO.	REV.
SHEET NO.	