


AREA PROTECTED	NO. OF NOZZLES	K FACTOR	SPRAY ANGLE	TRIGGER HEADS	LINE No. 1	LINE No. 2	LINE No. 3	LINE No. 4	LINE No. 10	LINE No. 11	LINE No. 12	TAG A	TAG B	TAG C	TAG D	TAG E	TAG F	TAG G	TAG H	TAG I	TAG J	TAG K	TAG L	TAG M	TAG N	TAG O	TAG AA	DV	SKID NO.
BULK CHEMICAL STORAGE AREA	64	79	140°	64	10"-WF-9259-Q35A	10"-WF-9250-Q35A	10"-WF-9251-Q15A	10"-WF-9252-Q15A	10"-WF-9249-Q35A	1"-AI-1771-S10A	1/2"-AI-9032-S10A	9026A	9026B	9026C	9026D	9026E	9026F	9026G	9026H	9026I	9026J	9026K	9026L	9026M	9026N	9026O	SP-045	DVS-26	

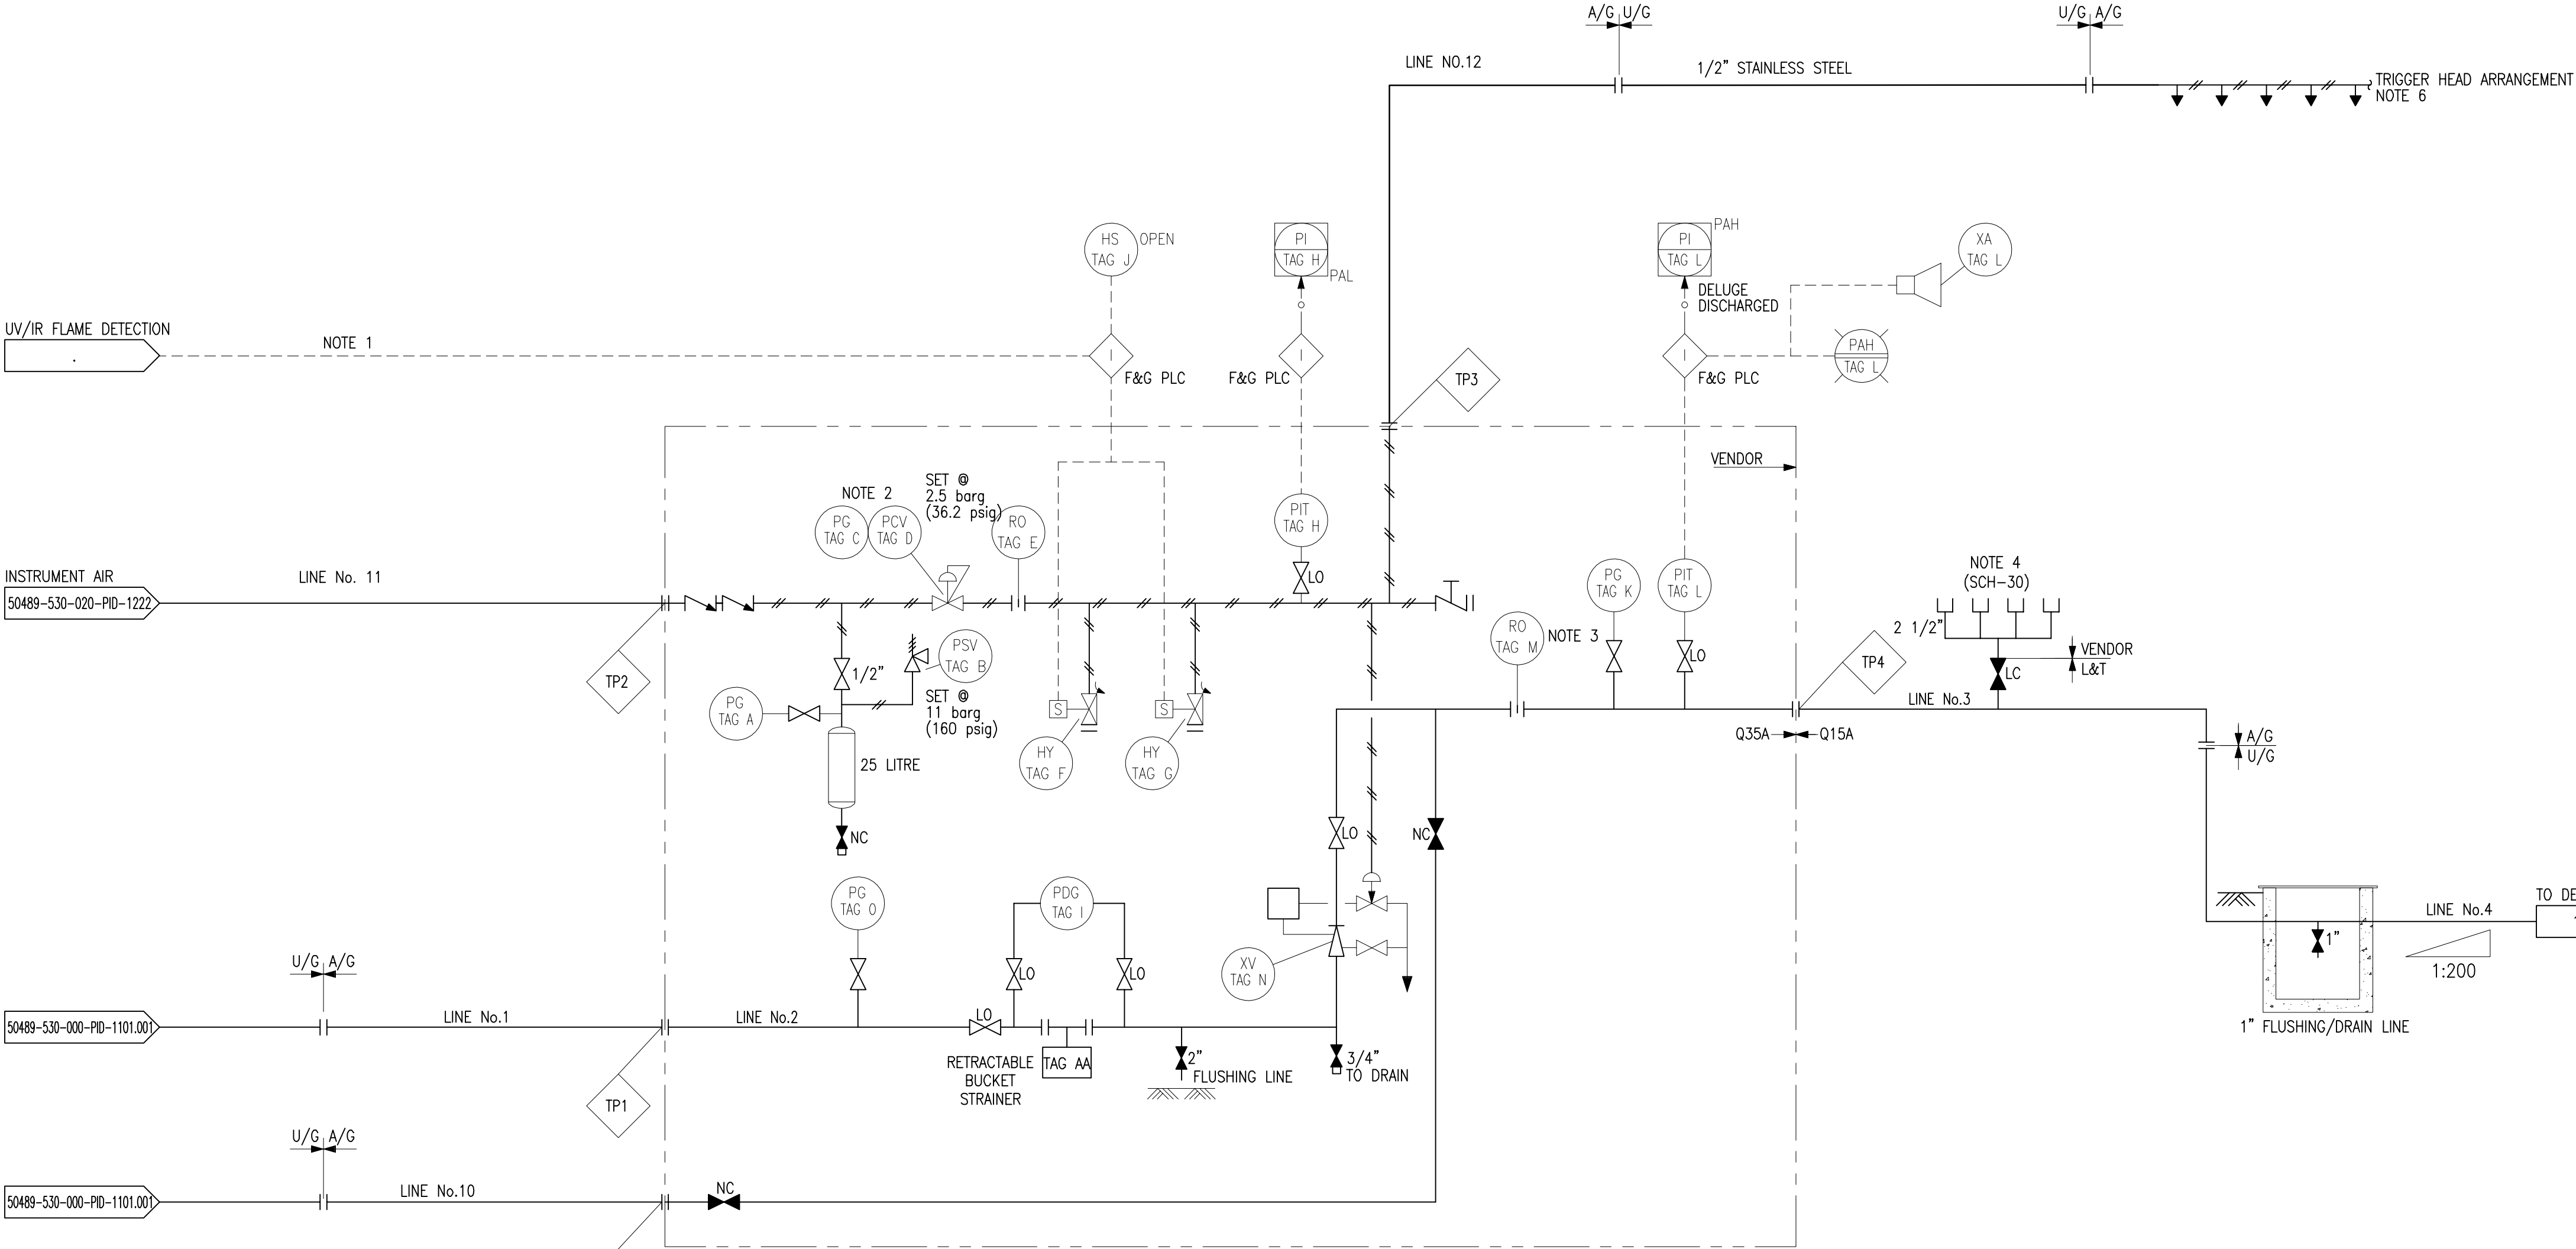

GENERAL NOTES:

A. FOR STANDARD SYMBOLS AND NOMENCLATURE SEE DRAWINGS 50489-530-020-PID-1104.001 & 1105.001.

B. ALL EQUIPMENT NUMBERS SHOWN ON THIS P&ID ARE PRECEDED BY 530-.

C. FOR ESDV, SBDV AND MOV DETAILS SEE DRAWINGS 50489-530-020-PID-1106.001 & 1107.001.

D. FOR MISCELLANEOUS PIPING DETAILS SEE DRAWING 50489-530-020-PID-1108.001.

E. FOR TYPICAL VALVING, DRAINAGE AND GENERAL ARRANGEMENT OF LEVEL INSTRUMENTATION, PUMPS AND CONTROL VALVES SEE DRAWING 50489-530-020-PID-1109.001.

NOTES:

1. UV/IR FLAME DETECTORS AUTOMATICALLY DETECT FIRE AND WHEN ACTIVATED A SIGNAL IS SENT TO THE F&G PANEL IN THE CCR.

2. AIR SET IS FITTED WITH AIR FILTER, REGULATOR AND PI.

3. RO SUPPLIED TO GIVE PRESSURE/LOSS CHARACTERISTICS OF THE DELUGE VALVE.

4. 4 WAY SUCTION COLLECTION HEAD IS INSTALLED TO ALLOW SECONDARY SUPPLY OF WATER TO DELUGE SYSTEM.

5. DELUGE VALVE IS DIAPHRAM TYPE DESIGNED FOR DELUGE OPERATION AND BE UL LISTED AND FM APPROVED

6. TRIGGER HEAD CONFIGURATION

1/2" FUSABLE PLUGS OVER PROTECTED EQUIPMENT ON A GENERAL 3 x 3 METRE MATRIX

7. 2 VALVES REQUIRED IN BYPASS LINE TO PREVENT UNNECESSARY LOSS OF WATER DUE TO GATE VALVE PASSING.

8. ADEQUATE DRAINAGE IS PROVIDED AROUND DELUGE SYSTEM TO AVOID ACCUMULATION OF WATER AROUND THE EQUIPMENT

9. PROVISION ARE MADE FOR PRESSURE TESTING AS PER NFPA 15 CLAUSE NO. 6.4.4 & 6.4.4.5 NEAR THE HYDRAULICALLY REMOTEST NOZZLE.

10. DELUGE VALVES ARE HELD CLOSED BY AIR PRESSURE SUPPLIED FROM THE INSTRUMENT AIR SYSTEM.

11. DELUGE VALVES SHALL FULLY OPEN WITHIN 10 SECONDS ON REMOVE OF INSTRUMENT AIR BY:

A. REMOTE OPERATION OF A PUSH BUTTON AT THE MAIN FIRE AND GAS PANEL, LOCATED IN THE CONTROL ROOM, TO ENERGIZE A SOLENOID VALVES IN INSTRUMENT AIR SUPPLY TO DELUGE VALVE.

B. LOCAL OPERATION OF A MECHANICAL AIR RELEASE UNIT OF DELUGE VALVE STATION.

12. SPRAY NOZZLE IS CONSTRUCTED FROM MAINE BRASS.

13. DELUGE VALVE STATIONS ARE PROTECTED FROM RADIATED HEAT BY THE PROVISION OF METAL RADIATION SHIELDS.

14. PIPE MOC (AS PER KOC-L-009):

3" SIZE AND BELOW : 90-10 COPPER NIKEL TO ASTM B 466 UNS.

4" SIZE AND ABOVE : CARBON STEEL API 5L GRB WITH PHENOLIC EPOXY COATING.

15. FLANGE INSULATION KITS ARE PROVIDED AT DISSIMILAR METAL JUNCTIONS HAVING ELECTROMOTIVE POTENTIAL DIFFERENCE GREATER THAN 0.05V AS PER CLAUSE 7.3.1.17 OF KOC-L-009.

16. INTERNALLY COATED UG PIPING ARE FLANGED SPOOLS AS PER KOC-L-009.

17. FLUSHING DRAIN PIT SHALL BE ACCESSIBLE FROM GROUND LEVEL.

18. THE UNDERGROUND SECTION IS EXTERNALLY COATED WITH 3 LAYERS EXTRDED HOPE AS PERKOC-P004 PART 6, REV-2 WITH THE INTERNAL PHENOLIC EPOXY ON THE PIPING SHALL BE AS PER KOC-P-005 REV-1.

19. THE ABOVE GROUND PIPING SECTION ARE COATED WITH SYSTEM A1-1 OF KOC-P-001 REV 3

20. TOP CHAMBER OF DELUGE VALVE IS CONNECTED TO WATER LINE & TO WATER INLET OF ACTUATOR WHEN THE AIR PRESSURE DROPS DUE TO DETECTION OF FIRE THE DIAPHRAM OF ACTUATOR IS LIFTED AND ALLOWS THE WATER PRESSURIZING DIAPHRAM OF DELUGE VALVE TOP CHAMBER TO DRAIN. THIS RELEASES THE PRESSURE IN THE TOP CHAMBER OF DELUGE VALVE ALLOWING THE DELUGE VALVE TO OPEN.

LEGENDS:

SYMBOL	DESCRIPTION
	FIRE WATER PIPING
	SPRAY NOZZLE
	REDUCER
	GATE VALVE
	END CAP

REFERENCE DRAWINGS:

50489-530-000-CAL-1016	HYDRAULIC CALCULATION FOR WATER SPRAY SYSTEM FOR BULK CHEMICAL STORAGE AREA
KOC-L-009	KOC STANDARD FOR FIRE PROTECTION SYSTEMS
50489-530-000-LAD-1065	FIRE WATER NETWORK LAYOUT

ZO	ISSUED FOR AS-BUILT	PAK/DEU	NIJ	SRA	RAK	12.08.18
01	RE-ISSUED FOR CONSTRUCTION	PAK/DEU	NIJ	SRA	RAK	16.07.16
0	ISSUED FOR CONSTRUCTION	PAK/DEU	NIJ	SRA	RAK	13.05.16
A	ISSUED FOR APPROVAL	PAK/DEU	NIJ	SRA	RAK	15.10.15
REV.	DESCRIPTION	DRAWN	CHECKED	HOD	PEM	DATE
				APPRD.		

CONTRACTOR REVISION

KUWAIT OIL CO.

K. S. C.

شركة نفط الكويت

ش.م.ك.

CONTRACTOR DETAILS:-

LARSEN & TOUBRO LIMITED

FARIDABAD

PROJECT TITLE:-

NEW GATHERING

CENTRE GC-30 IN NORTH KUWAIT

DOCUMENT TITLE:-

PIPING & INSTRUMENTATION DIAGRAM

WATER SPRAY SYSTEM FOR BULK CHEMICAL STORAGE AREA

PROJECT NO.	DRAWING NO.
CONTRACTOR DRG. NO.	REV. KOC DRG. NO.
50489-530-000-PID-1128.001	ZO
SHEET NO. 1 OF 2	SHEET NO.
COMPANY DRG. NO.	REV.
SHEET NO.	