


L-504B/505B
OIL FILTERS

CAPACITY m3/h (BPD) : 2.5 (376)
ID mm (ft.-in) : 128.2 (0'-5")
LENGTH /T mm (ft.-in) : 446 (1'-5.5")
OP PRESS / DES PRESSURE barg (psig) : 3 / 5.4 (43.5 / 78.5)
OP TEMP / DESIGN TEMP °C (°F) : 65 / 105 / -3 (149 / 221 / 26.6)
UTC NO. :
TRIM NO. : L504B/505B-S10A

E-133B
LUBE OIL COOLER

DUTY MMKcal/hr. (MMBTU/hr) : 0.015 (0.061)
OP PRESS / DES PRESSURE barg (psig) : 3 / 5.4 (43.5 / 78.5)
OP TEMP INLET / OUTLET °C (°F) : 75.4 / 65 (167.7 / 149)
DESIGN TEMP °C (°F) : 105 / -3 (221 / 26.6)
UTC NO. :
TRIM NO. : ET-E133B-S10A

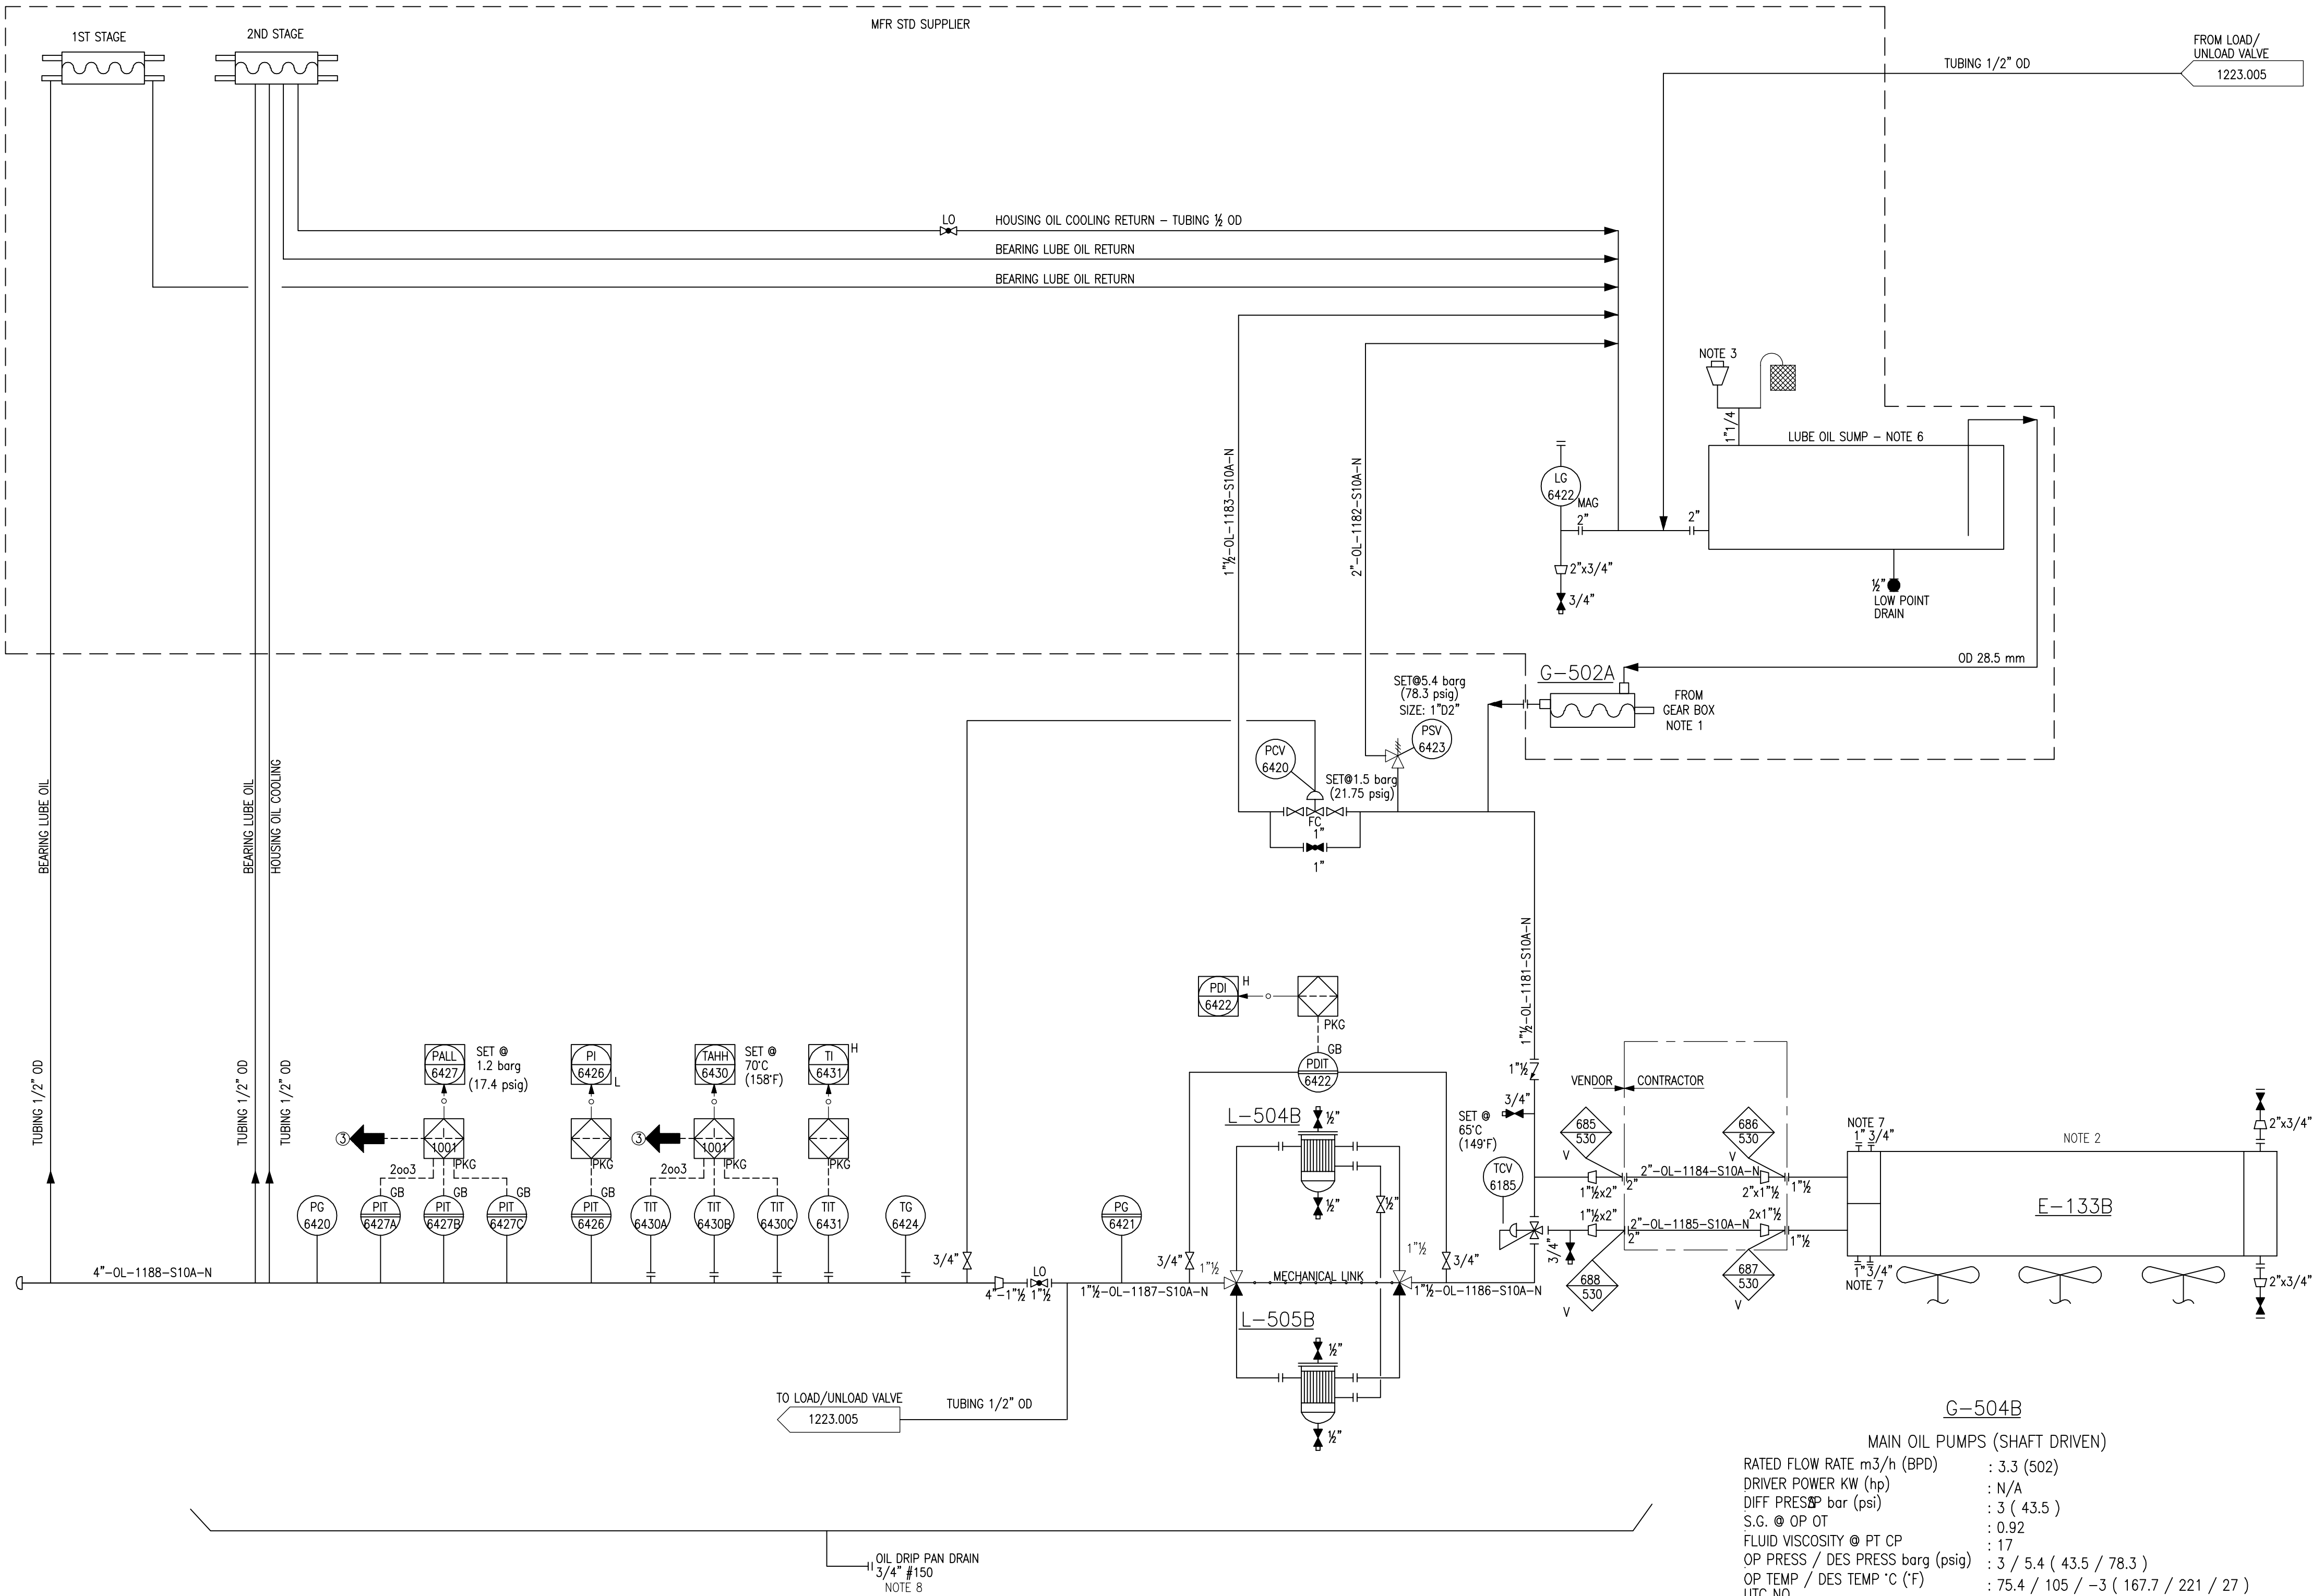

GENERAL NOTES:

- FOR STANDARD SYMBOLS AND NOMENCLATURE SEE DRAWINGS 50489-530-020-PID-1104.001 & .002.
- ALL EQUIPMENT NUMBERS SHOWN ON THIS P&ID ARE PRECEDED BY 530--.
- ALL INSTRUMENT NUMBERS SHOWN ON THIS P&ID ARE PRECEDED BY 030--.
- FOR TYPICAL INSTRUMENT CONNECTION, SBOV, XV, MOV & ESDV DETAILS SEE DRAWINGS 50489-530-020-PID-1106.001, .002, .003, .004, .005, .006 & .007.
- FOR MISCELLANEOUS PIPING TYPICAL VALVING, DRAINAGE & GENERAL ARRANGEMENT OF LEVEL INSTRUMENTS, PUMPS, STRAINERS & CONTROL VALVES SEE DRAWINGS 50489-530-020-PID-1108.001 TO 1108.010.
- DRAWING NUMBERS SHOWN IN P&ID CONTINUATION BOXES ARE ABBREVIATED SHOWING SEQUENTIAL NUMBERS ONLY. THE FULL FORM OF THE DRAWING NUMBER IS 50489-530-020-PID-XXXX.SHT.NO.
- FOR MATERIAL SELECTION DIAGRAM SEE DRAWINGS 50489-530-020-MSD-1001.001 TO 1023.
- DETAIL NUMBERING FOR CI, SC, CC & CP SEE DRAWING 50489-530-020-PID-1108.003.
- PAINTING & COATING ARE IN ACCORDANCE WITH KOC-P-001.
- LOW POINT DRAIN & HIGH POINT VENT ARE INDICATED IN P&ID.
- FOR CAUSE & EFFECT REFER DOC. NO. 50489-530-020-PHL-1009.
- FOR ALARM VALUES REFER DOC. NO. 50489-530-020-SUM-1006.

NOTES:

- THE COMPRESSOR USES THE MAIN DRIVE MOTOR FOR BOTH STAGES OF COMPRESSION AND FOR THE LUBE OIL PUMP.
- INTERCOOLER, AFTERCOOLER & THE LUBE OIL COOLER ARE INSTALLED ON THE SAME BAY. FANS PHILOSOPHY IS 3:50%. FANS ARE COMMON TO INTERCOOLER/AFTERCOOLER/LUBE OIL COOLER. FOR DETAIL REFER PID: 1220.004.
- OIL FILLING PORT.
- LUBE OIL TO BE SUITABLE FOR IMMEDIATE START AT ALL TEMPERATURES IN THE RANGE -3°C TO MAXIMUM AMBIENT.
- FOR SET POINTS OF ALARM, REFER TO THE VENDOR DOCUMENT "50489-530-020-00048-LST-V003 ALARM & TRIP SET-POINT SUMMARY FOR PLANT AIR COMPRESSOR PACKAGE"
- LUBE OIL PUMP IS AN INTEGRAL PART OF COMPRESSOR ASSEMBLY.
- MECHANICAL PREDISPOSITION FOR TEMPORARY INSTALLATION OF PRESSURE AND TEMPERATURE INSTRUMENTS ARE INSTALLED ON COOLERS. THESE CONNECTIONS ARE NPT TYPE AND ARE 3/4" FOR PRESSURE INSTRUMENTS AND 1" FOR THERMOWELL. FOR MORE INFORMATION REFER TO VENDOR DOCUMENT "50489-530-040-00048-DTL-V005 FABRICATION DRAWING FOR INSTRUMENT & PLANT AIR COOLERS"
- TO SKID EDGE
- VENDOR PID NO: 50489-530-020-00048-PID-V001 SHEET 3 OF 4.

AS-BUILT	
KOC APPROVAL	
NAME / KOC No:	
DESIGNATION :	
GROUP / TEAM :	
SIGNATURE :	
DATE :	

AS-BUILT	
LARSEN & TOUBRO LIMITED	
NAME :	VAIBHAV VERMA
DESIGNATION :	AGM
SIGNATURE :	
DATE :	28-Aug-2018
DEPT/ DIVISION :	ENGINEERING

ZO	ISSUED FOR AS-BUILT	HSH/ABY	AKG	SRA	RAK	28.08.18
O	ISSUED FOR CONSTRUCTION	HSH/ABY	AKG	SRA	RAK	14.06.16
B	ISSUED INCORPORATED CLIENT COMMENTS	PAK/ABY	AKG	SRA	RAK	17.05.16
A	ISSUED FOR APPROVAL	JSI/ABY	AKG	SRA	RAK	17.10.15
REV.	DESCRIPTION	DRAWN	CHECKED	HOD	PEM	DATE

CONTRACTOR REVISION




شركة نفط الكويت
K. S. C.
2'-3/4"



شركة نفط الكويت
K. S. C.
ش.م.ك.

CONTRACTOR DETAILS:-



LARSEN & TOUBRO LIMITED
FARIDABAD

PROJECT TITLE:-

NEW GATHERING CENTRE GC-30
IN NORTH KUWAIT

DOCUMENT TITLE:-			
PIPING & INSTRUMENTATION DIAGRAM PA COMPRESSOR PACKAGE (K-103B) LUBE OIL SYSTEM			
PROJECT NO.	DRAWING NO.		
EF1902	CONTRACTOR DRG. NO.	REV.	KOC DRG. NO.
	50489-530-020-PID-1223.007	Z0	
	SHEET NO. 7 OF 8		
	COMPANY DRG. NO.	REV.	
EF1902-530-DCO-PID-0223.001	A3		
SHEET NO.			