


GENERAL NOTES:

1. TYPE OF VALVE IS AS PER RESPECTIVE P&ID.
2. DELETED.
3. ALL MOVs ARE SUPPLIED WITH HANDWHEELS.
4. A COMMAND/MISMATCH LOGIC IS DEVELOPED TO DETECT FAULT WITHIN THE VALVE ACTUATOR AND LIMIT SWITCHES.
5. DELETED.
6. DELETED.
7. DELETED.
8. ALSO REFER TO LEGEND DRAWINGS 50489-530-020-PID-1107.001, 002 & 003 FOR FURTHER VALVE DETAILS
9. LOCAL CONTROL PANEL FOR MOVs ARE LOCATED AT ACCESSIBLE LOCATION.
10. SSLS OR PLC IS USED WHEREVER IS APPLICABLE.
11. SEQUENCE OPERATION IS DEVELOPED BASED ON OPERATION PHILOSOPHY.
12. MOV ARE AS PER LINE RATING.
13. DELETED.

AS-BUILT	
KOC APPROVAL	
NAME / KOC No:	
DESIGNATION :	
GROUP / TEAM :	
SIGNATURE :	
DATE :	

AS-BUILT	
LARSEN & TOUBRO LIMITED	
NAME : VAIBHAV VERMA	
DESIGNATION : AGM	
SIGNATURE :	
DATE : 15-Aug-2018	
DEPT/ DIVISON : ENGINEERING	

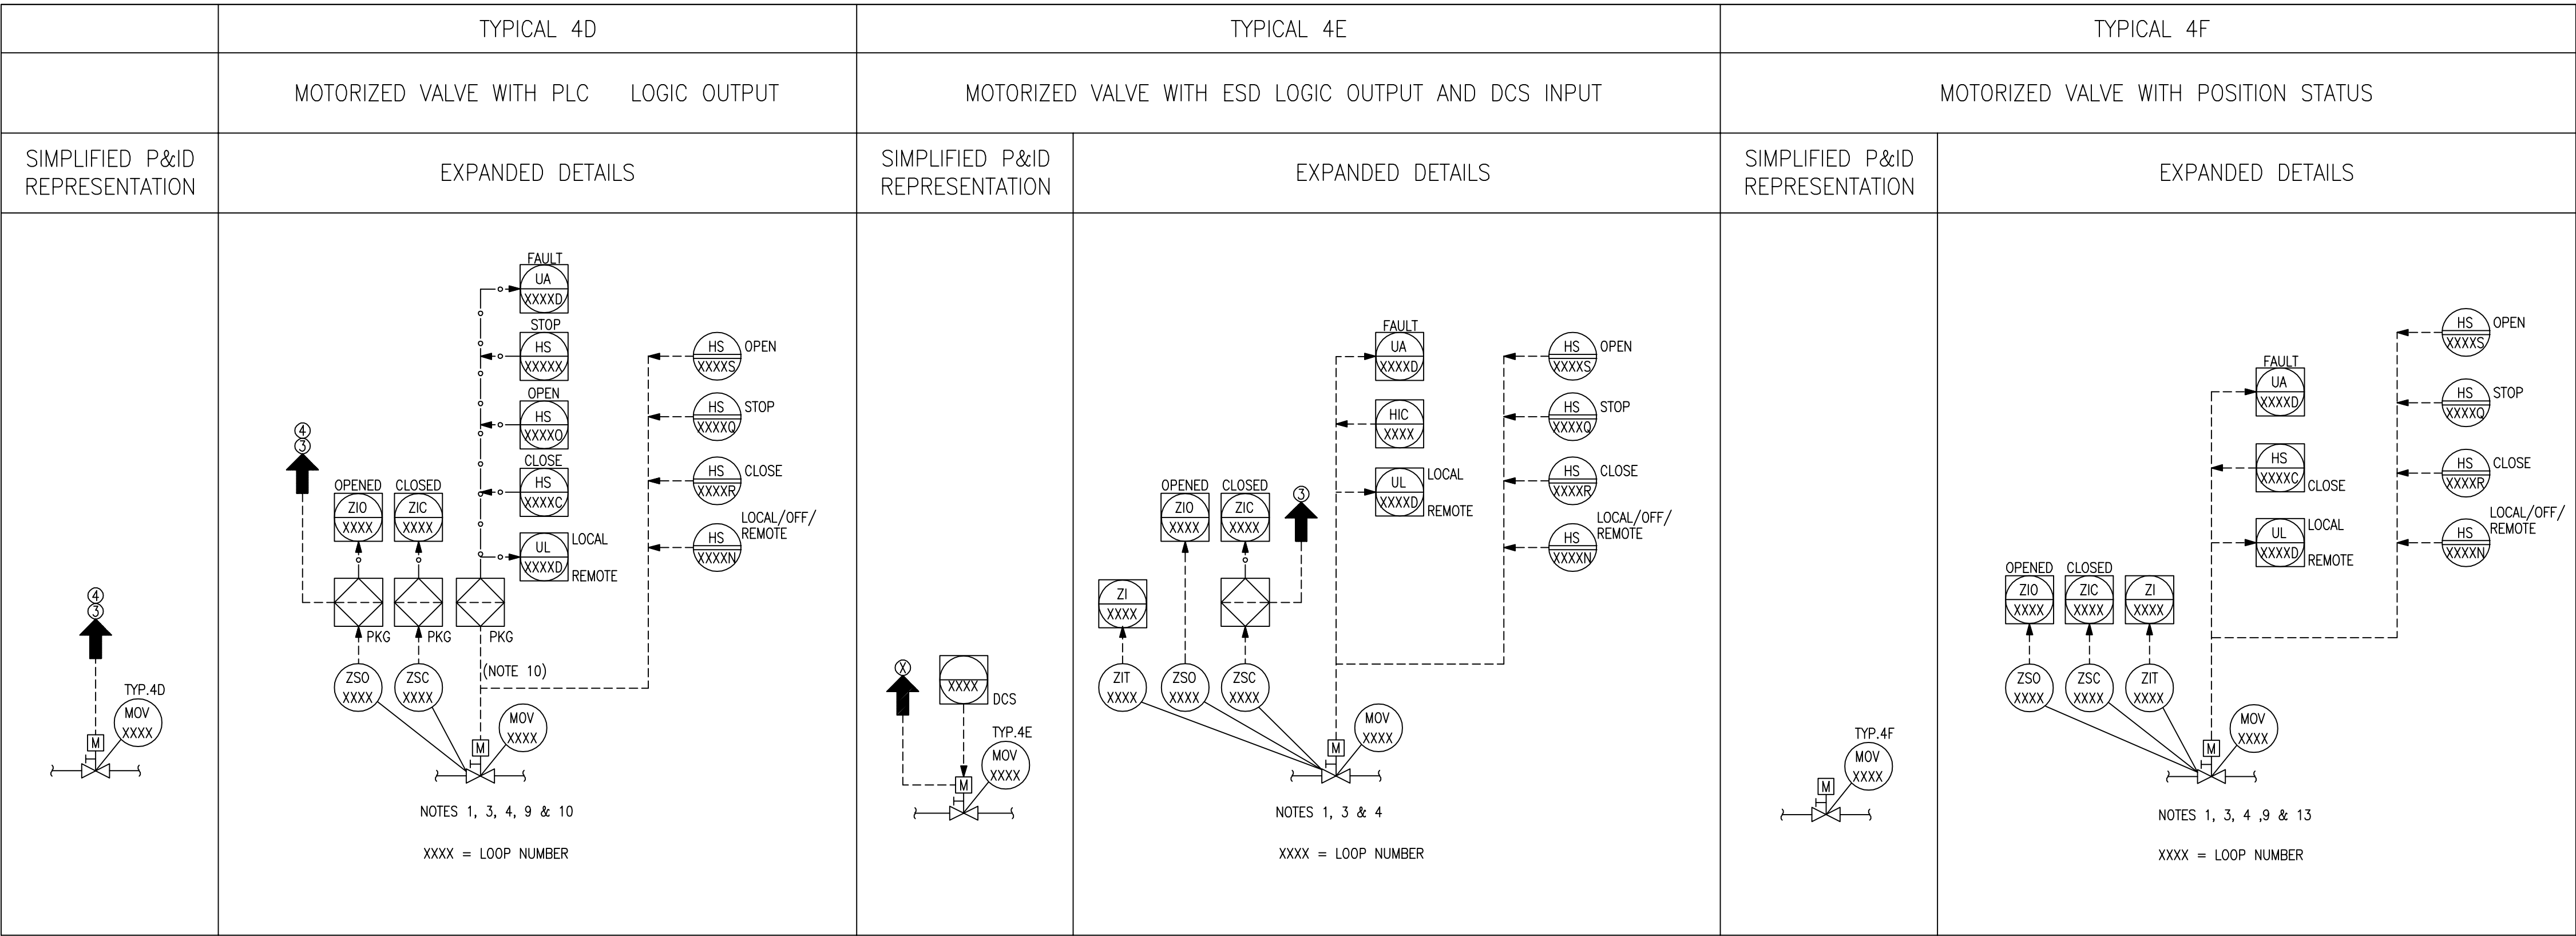

Z0	ISSUED FOR AS-BUILT	PAK/ABY	AKG	SRA	RAK	15.08.18
0	ISSUED FOR CONSTRUCTION	PAK/ABY	AKG	SRA	RAK	30.03.16
C	ISSUED INCORPORATED CLIENT COMMENTS	BAK/ABY	AKG	SRA	RAK	28.10.15
OC	ISSUED INCORPORATED CLIENT COMMENTS	BAK/ABY	AKG	SRA	RAK	05.06.15
B	GENERAL REVISION	JSI/VSA	AKG	SRA	RAK	17.01.15
A	ISSUED FOR APPROVAL	JSI/VSA	AKG	SRA	RAK	24.11.14
REV.	DESCRIPTION	DRAWN	CHECKED	HOD	PEM	DATE
				APPRD.		

CONTRACTOR REVISION



CONTRACTOR DETAILS:-  
**LARSEN & TOUBRO LIMITED**  
FARIDABAD

PROJECT TITLE:-  
NEW GATHERING CENTRE GC-30  
IN NORTH KUWAIT

DOCUMENT TITLE:-  
**PIPING & INSTRUMENTATION DIAGRAM**  
STANDARD DRAWING (MOV DETAIL)

PROJECT NO.	DRAWING NO.
EF1902	CONTRACTOR DRG. NO. 50489-530-020-PID-1106.006
	SHEET NO. 6 OF 7 COMPANY DRG. NO. EF1902-530-DCO-PID-0107.001
	SHEET NO.
	REV. KOC DRG. NO. Z0
	REV. SHEET NO.
	REV. A3