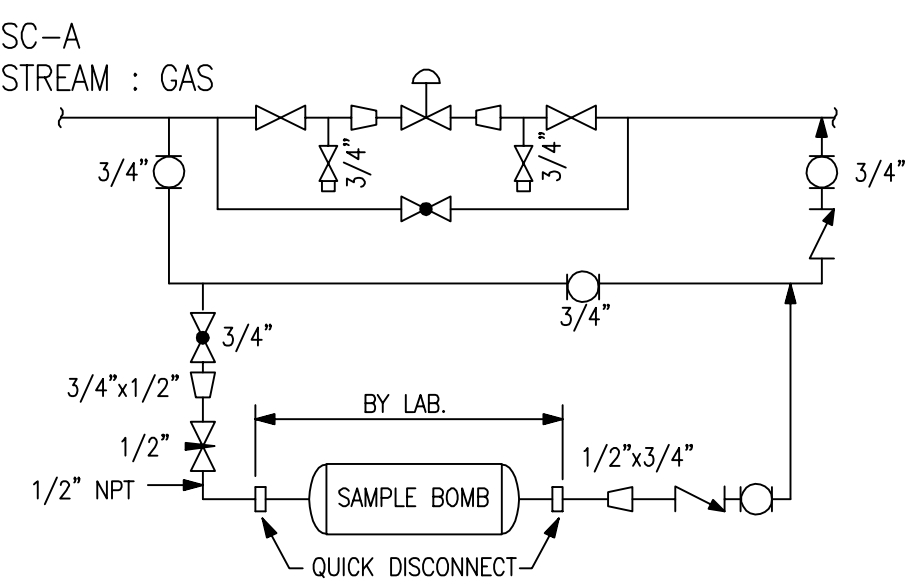
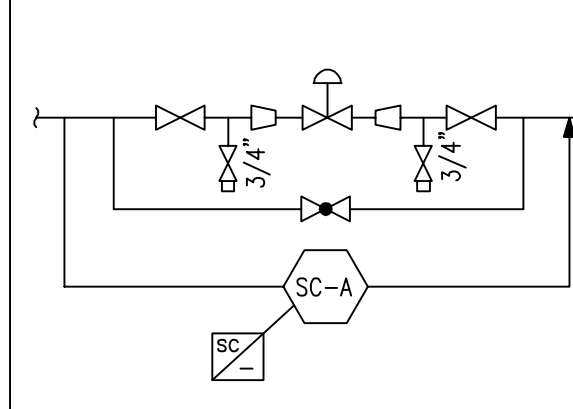
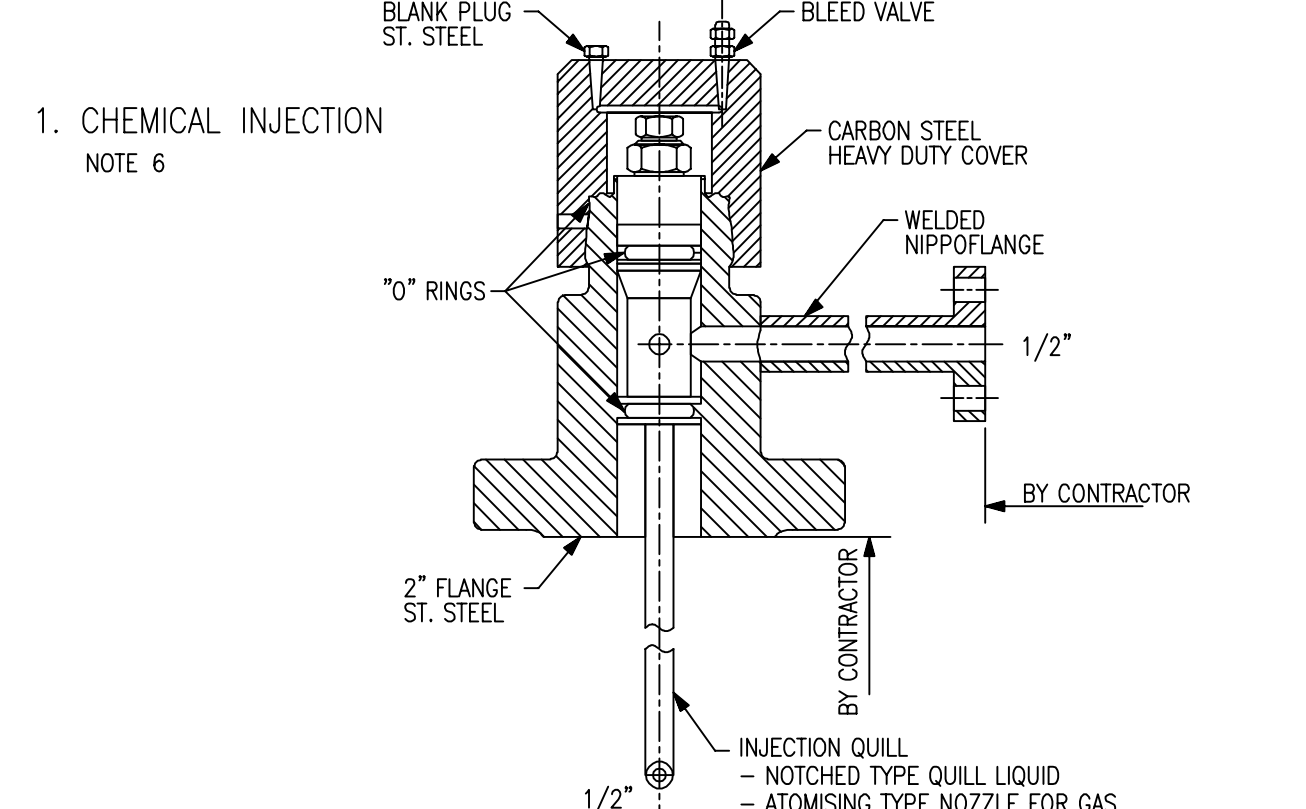
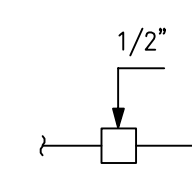
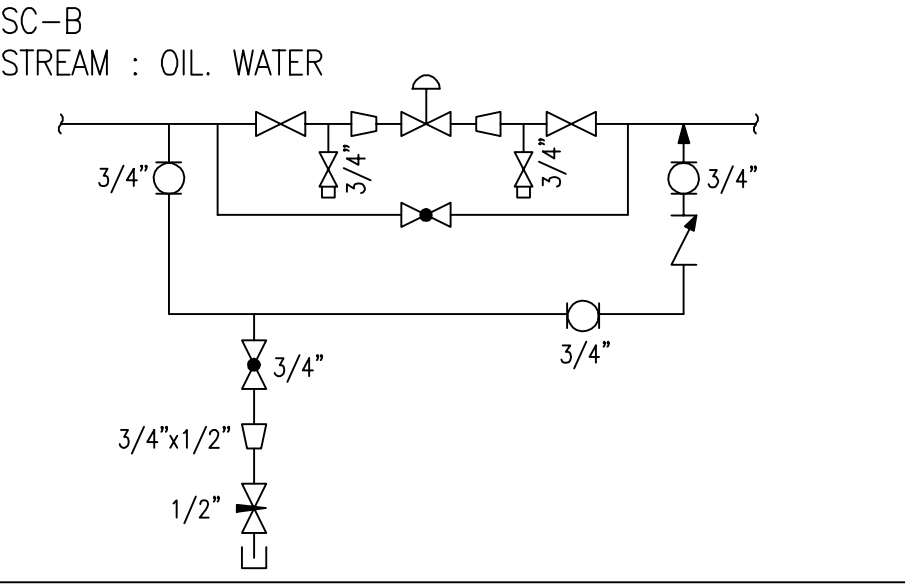
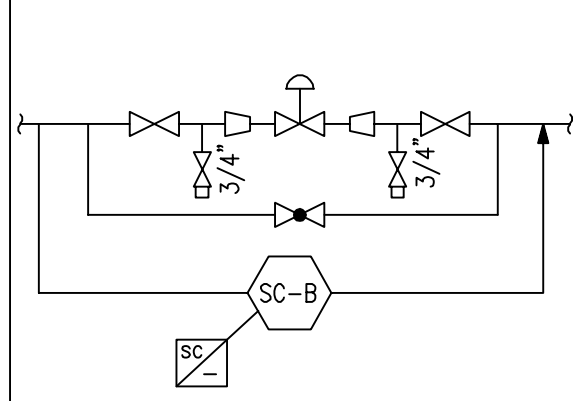
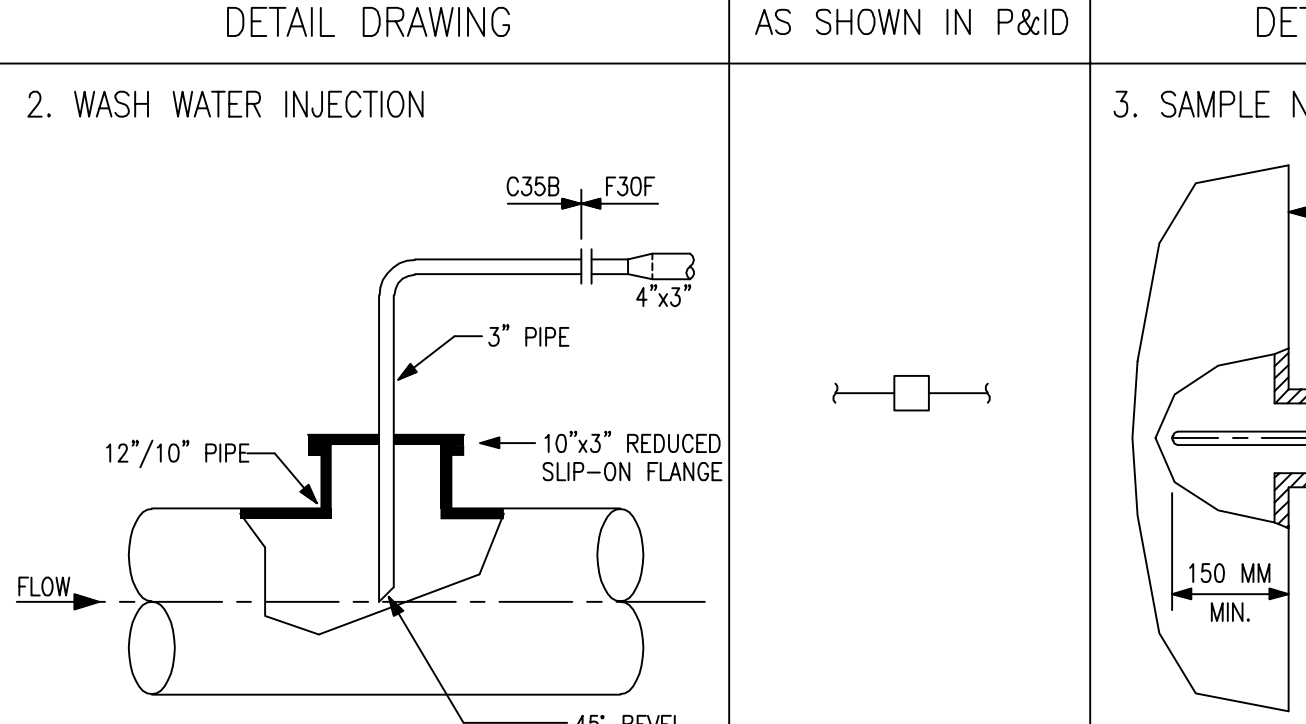
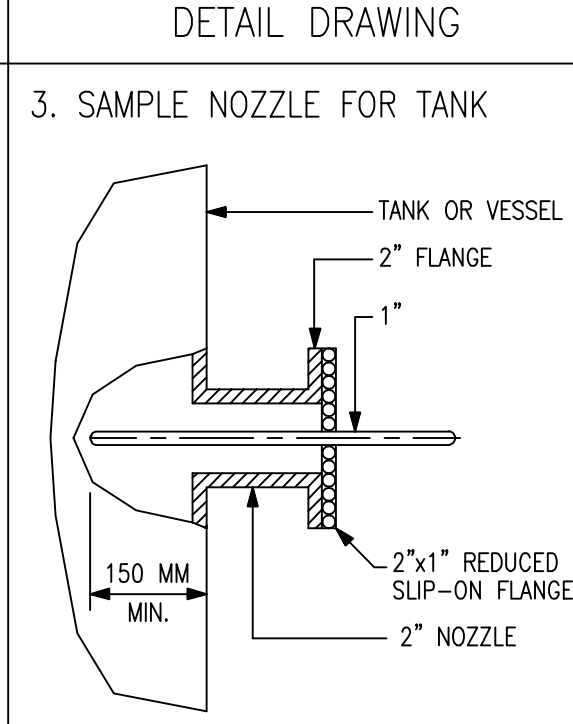
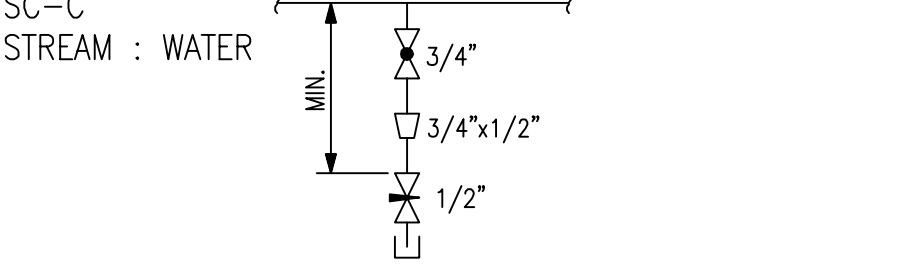
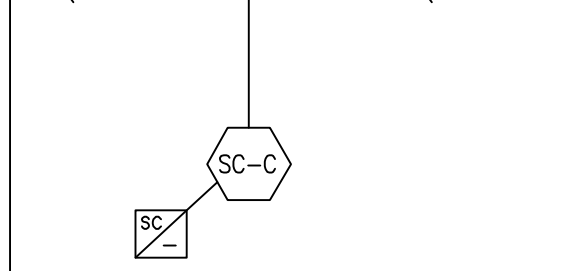
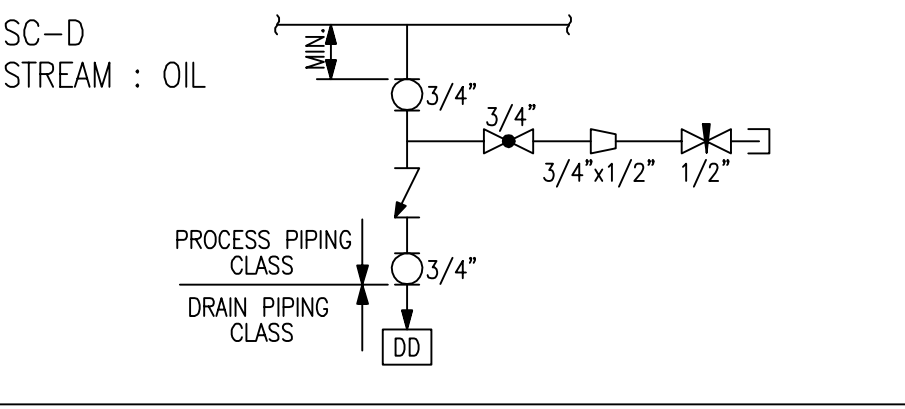
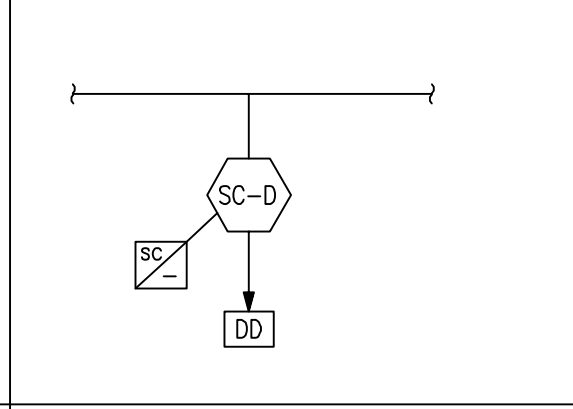
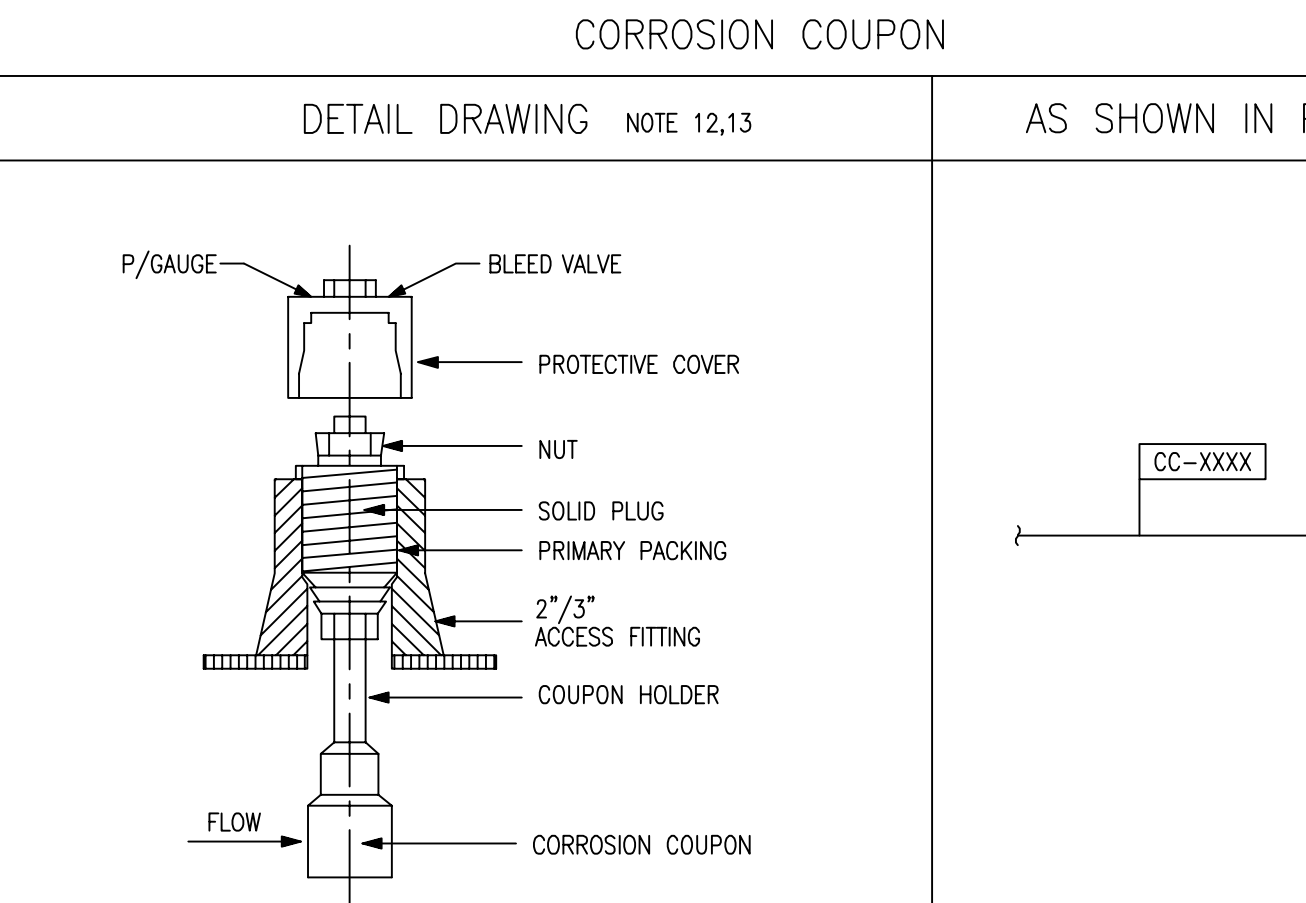
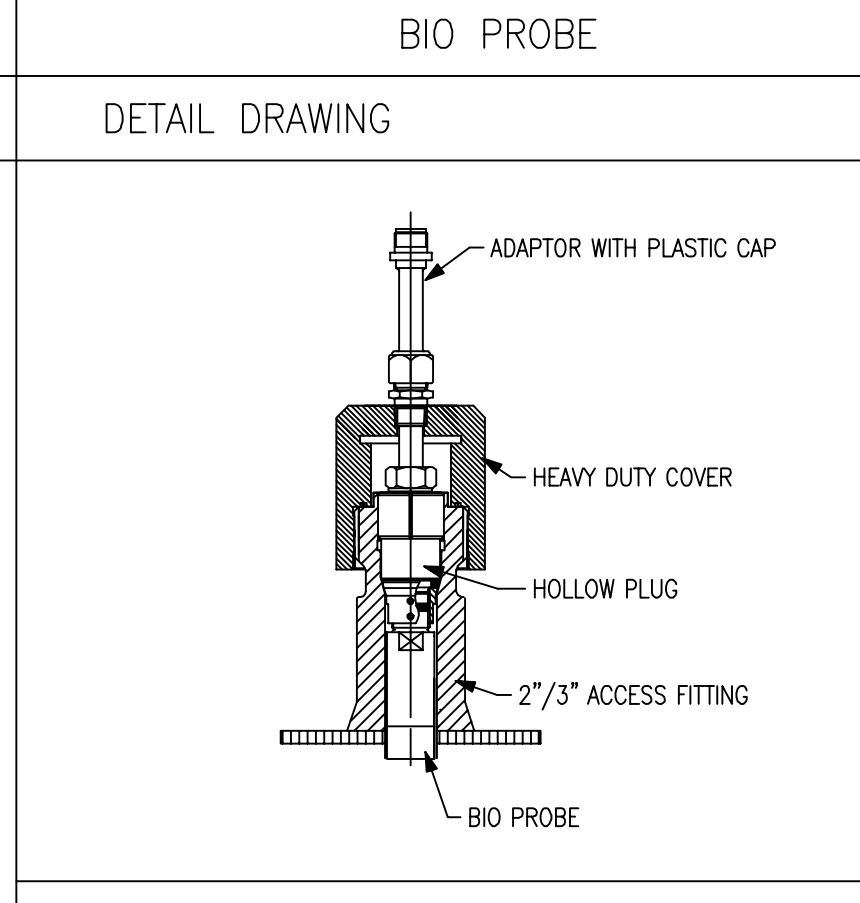
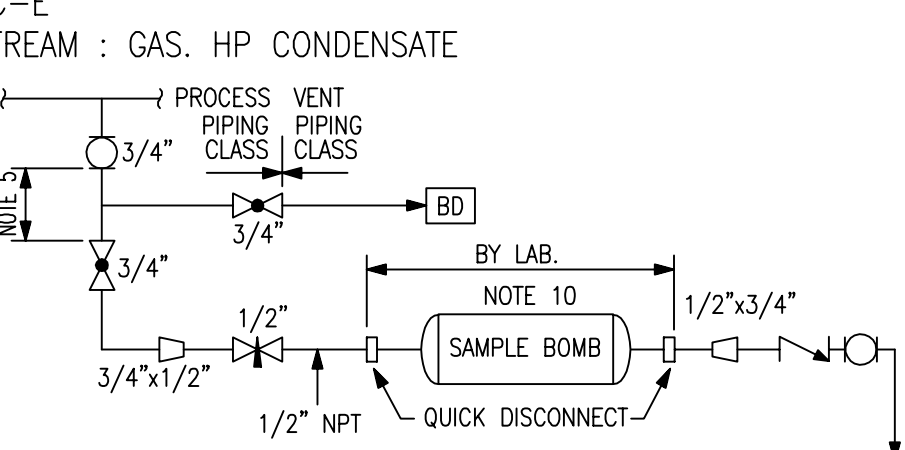
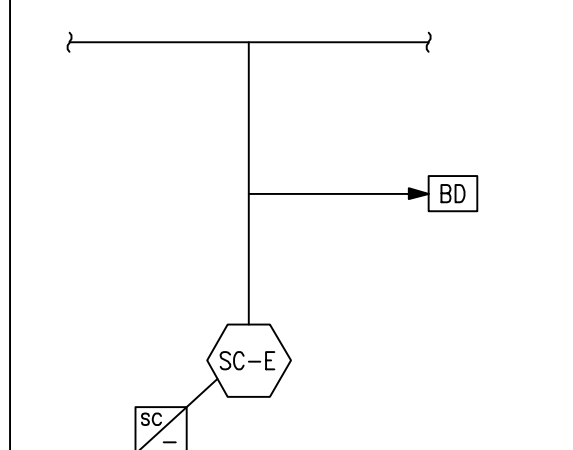
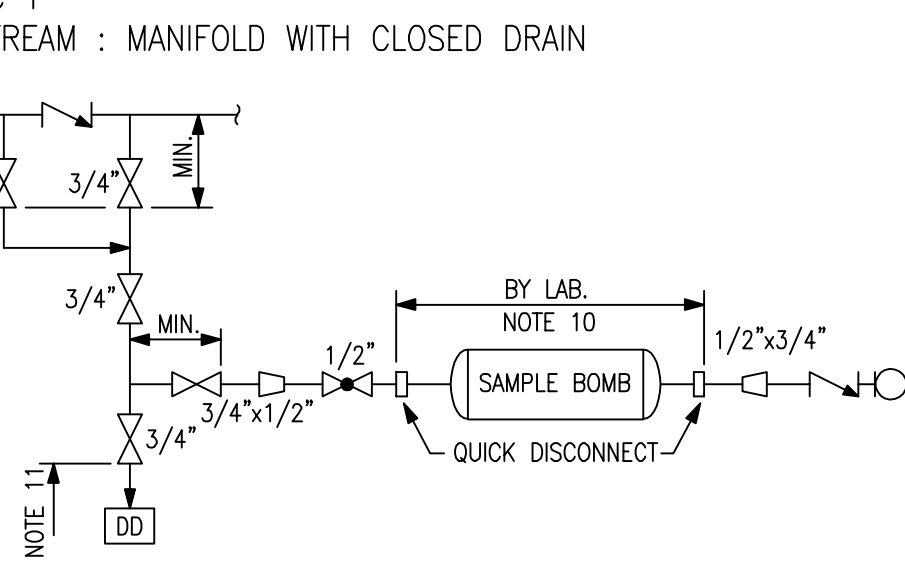
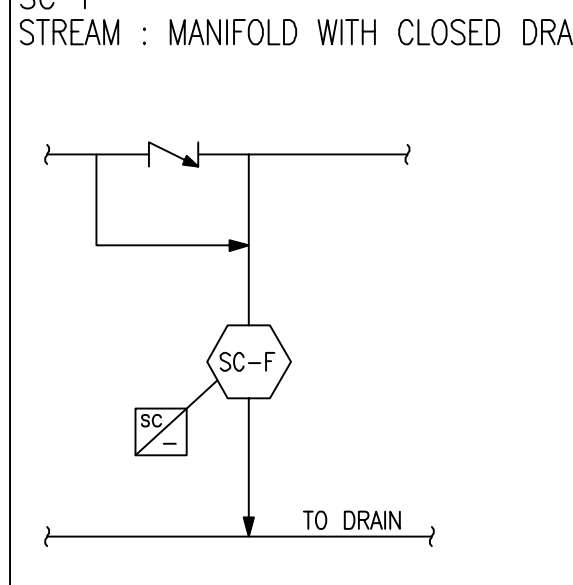
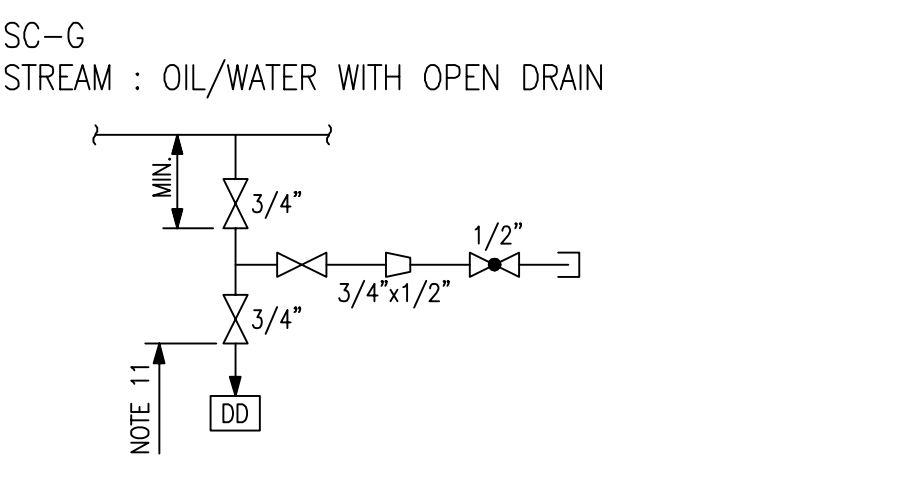
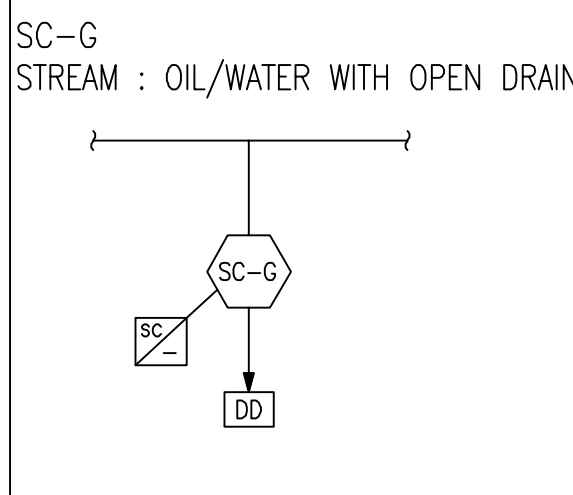
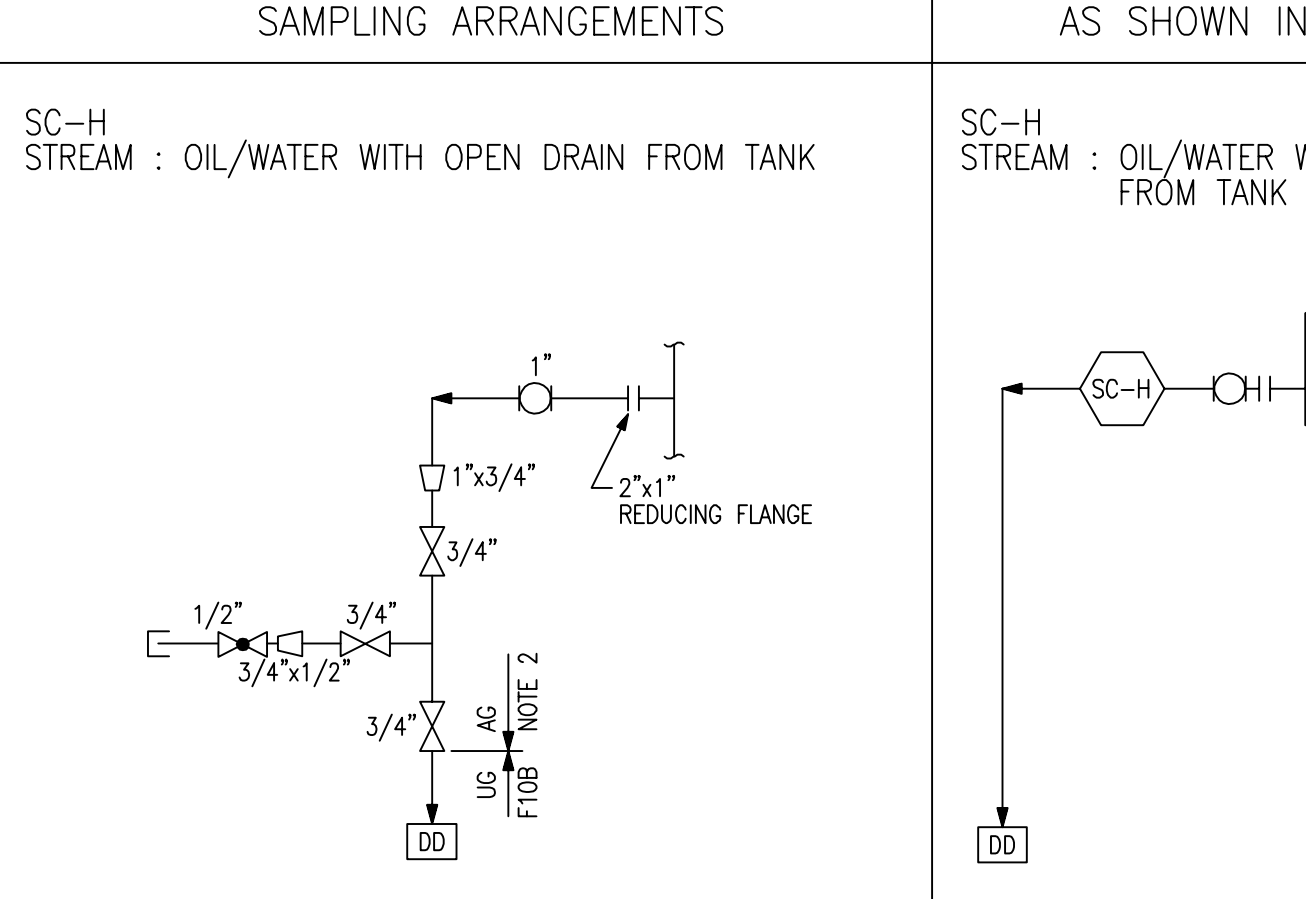
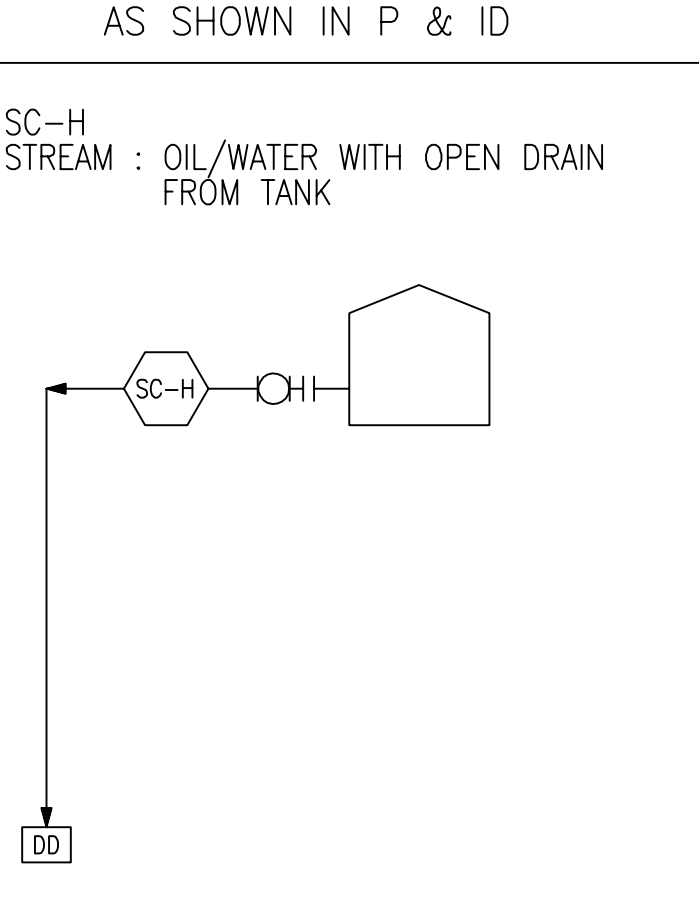
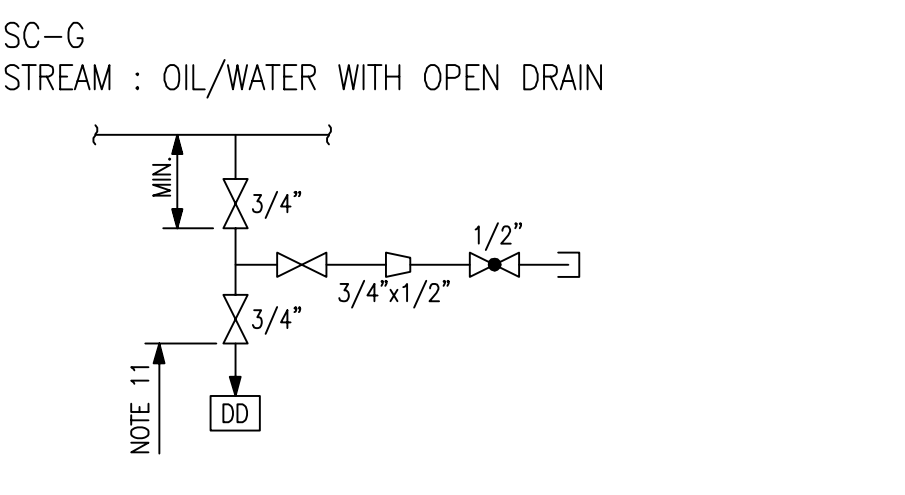
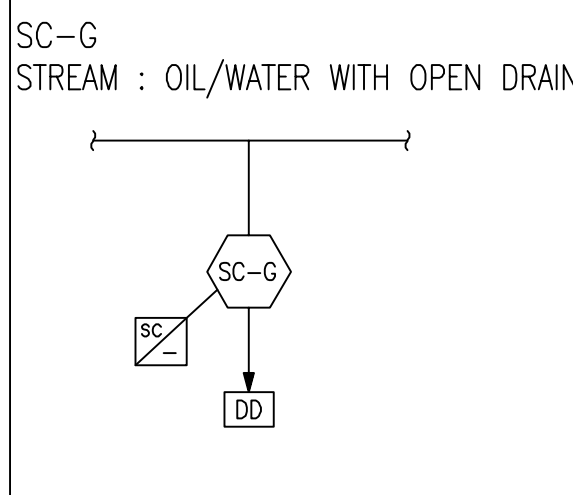
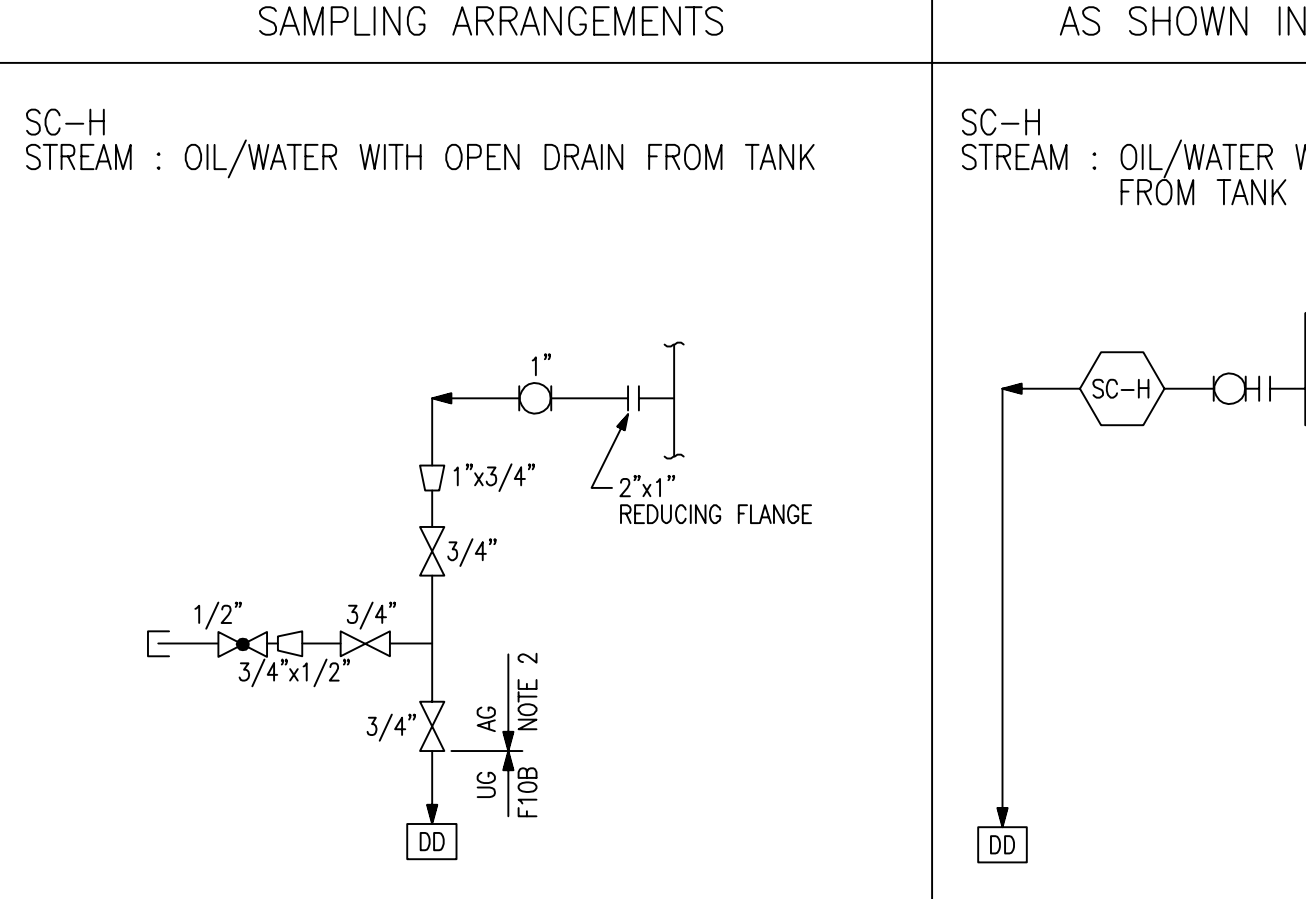
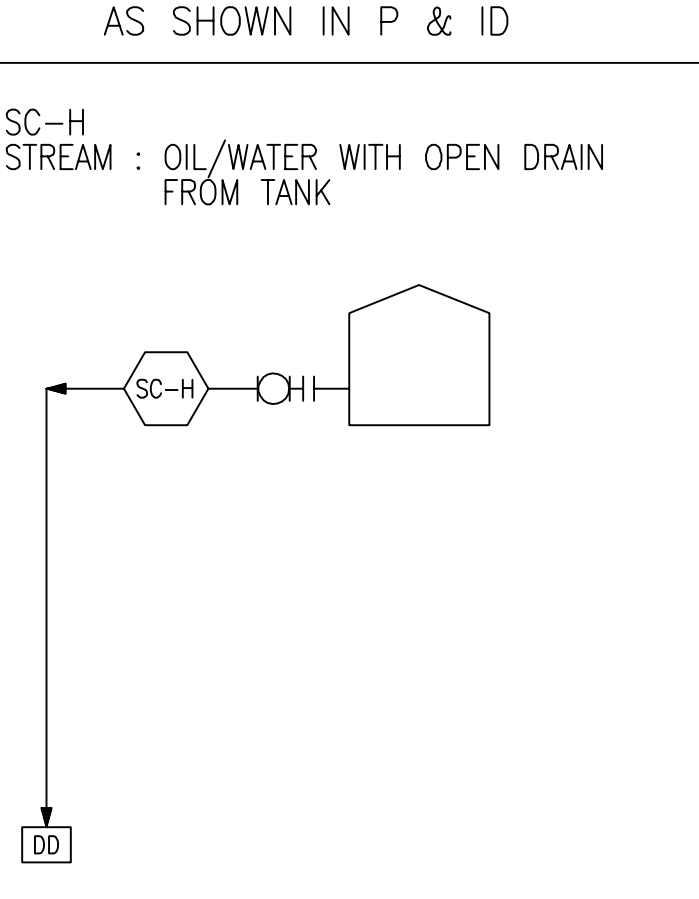


SAMPLE CONNECTION		INJECTION AND SAMPLE NOZZLE		FIRE ENGINE SUCTION RISER		GENERAL NOTES:	
SAMPLING ARRANGEMENTS		AS SHOWN IN P & ID		DETAIL DRAWING		AS SHOWN IN P&ID	
<div>SC-A</div> <div>STREAM : GAS</div> 				<div>1. CHEMICAL INJECTION</div> <div>NOTE 6</div> 			
<div>SC-B</div> <div>STREAM : OIL. WATER</div> 				<div>2. WASH WATER INJECTION</div> 		<div>3. SAMPLE NOZZLE FOR TANK</div> 	
<div>SC-C</div> <div>STREAM : WATER</div> 				CORROSION COUPON		BIO PROBE	
<div>SC-D</div> <div>STREAM : OIL</div> 				<div>DETAIL DRAWING</div> <div>NOTE 12,13</div> 		<div>DETAIL DRAWING</div> 	
<div>SC-E</div> <div>STREAM : GAS. HP CONDENSATE</div> 				CORROSION COUPON		BIO PROBE	
<div>SC-F</div> <div>STREAM : MANIFOLD WITH CLOSED DRAIN</div> 		<div>SC-F</div> <div>STREAM : MANIFOLD WITH CLOSED DRAIN</div> 		SAMPLING ARRANGEMENTS		AS SHOWN IN P & ID	
<div>SC-G</div> <div>STREAM : OIL/WATER WITH OPEN DRAIN</div> 		<div>SC-G</div> <div>STREAM : OIL/WATER WITH OPEN DRAIN</div> 		<div>SC-H</div> <div>STREAM : OIL/WATER WITH OPEN DRAIN FROM TANK</div> 		<div>SC-H</div> <div>STREAM : OIL/WATER WITH OPEN DRAIN FROM TANK</div> 	
<div>SC-G</div> <div>STREAM : OIL/WATER WITH OPEN DRAIN</div> 		<div>SC-G</div> <div>STREAM : OIL/WATER WITH OPEN DRAIN</div> 		<div>SC-H</div> <div>STREAM : OIL/WATER WITH OPEN DRAIN FROM TANK</div> 		<div>SC-H</div> <div>STREAM : OIL/WATER WITH OPEN DRAIN FROM TANK</div> 	

AS-BUILT

KOC APPROVAL

NAME / KOC No:

DESIGNATION :

GROUP / TEAM :

SIGNATURE :

DATE :

AS-BUILT

LARSEN & TOUBRO LIMITED

NAME : VAIBHAV VERMA

DESIGNATION : AGM

SIGNATURE :

DATE : 05-Sep-2018

DEPT/ DIVISION : ENGINEERING

Z0	ISSUED FOR AS-BUILT	SHH/JCP	AKG	SRA	DER	05.09.18
01	ISSUED FOR CONSTRUCTION	SHH/JCP	AKG	SRA	DER	30.12.16
0	ISSUED FOR CONSTRUCTION	PAK/ABY	AKG	SRA	RAK	07.05.16
D	ISSUED INCORPORATED CLIENT COMMENTS	BAK/ABY	AKG	SRA	RAK	04.01.16
C	ISSUED INCORPORATED CLIENT COMMENTS	BAK/ABY	AKG	SRA	RAK	28.10.15
0C	ISSUED INCORPORATED CLIENT COMMENTS	BAK/ABY	AKG	SRA	RAK	08.09.15
B	ISSUED INCORPORATED CLIENT COMMENTS	JSI/VSA	AKG	SRA	RAK	20.01.15
A	ISSUED FOR APPROVAL	JSI/VSA	AKG	SRA	RAK	24.11.14
REV.	DESCRIPTION	DRAWN	CHECKED	HOD	PEM	DATE
				APPRD.		

CONTRACTOR REVISION

KUWAIT OIL CO.

K. S. C.

شركة نفط الكويت

ش.م.ك.

CONTRACTOR DETAILS:-

LARSEN & TOUBRO LIMITED

FARIDABAD

PROJECT TITLE:-

NEW GATHERING CENTRE GC-30

IN NORTH KUWAIT

DOCUMENT TITLE:-

PIPING & INSTRUMENTATION DIAGRAM

STANDARD DRAWING (PIPING DETAIL)

PROJECT NO.	DRAWING NO.		
EF1902	CONTRACTOR DRG. NO.	REV.	KOC DRG. NO.
	50489-530-020-PID-1108.001	Z0	
	SHEET NO. 1 OF 10	REV.	SHEET NO.
	COMPANY DRG. NO.		
	EF1902-530-DC0-PID-0108.001	A1	
	SHEET NO.		