


PU-1243  
DF POWER UNIT  
RATING : 100 KVA, 480 VAC, 50 HZ, 3PHASE  
PRIMARY CURRENT : 138AAC  
SECONDARY VOLTAGE : 34 KV DC PEAK.

TR-1243  
DUAL FREQUENCY AUTO TRANSFORMER  
RATING : 136 KVA, 440 VAC, 50 HZ, 3PHASE  
PRIMARY CURRENT : 179AAC  
SECONDARY CURRENT : 164AAC  
SECONDARY VOLTAGE : 480VAC

CP-1243  
DF LRC-II PANEL  
RATING : 110VAC, 50HZ, 1PHASE

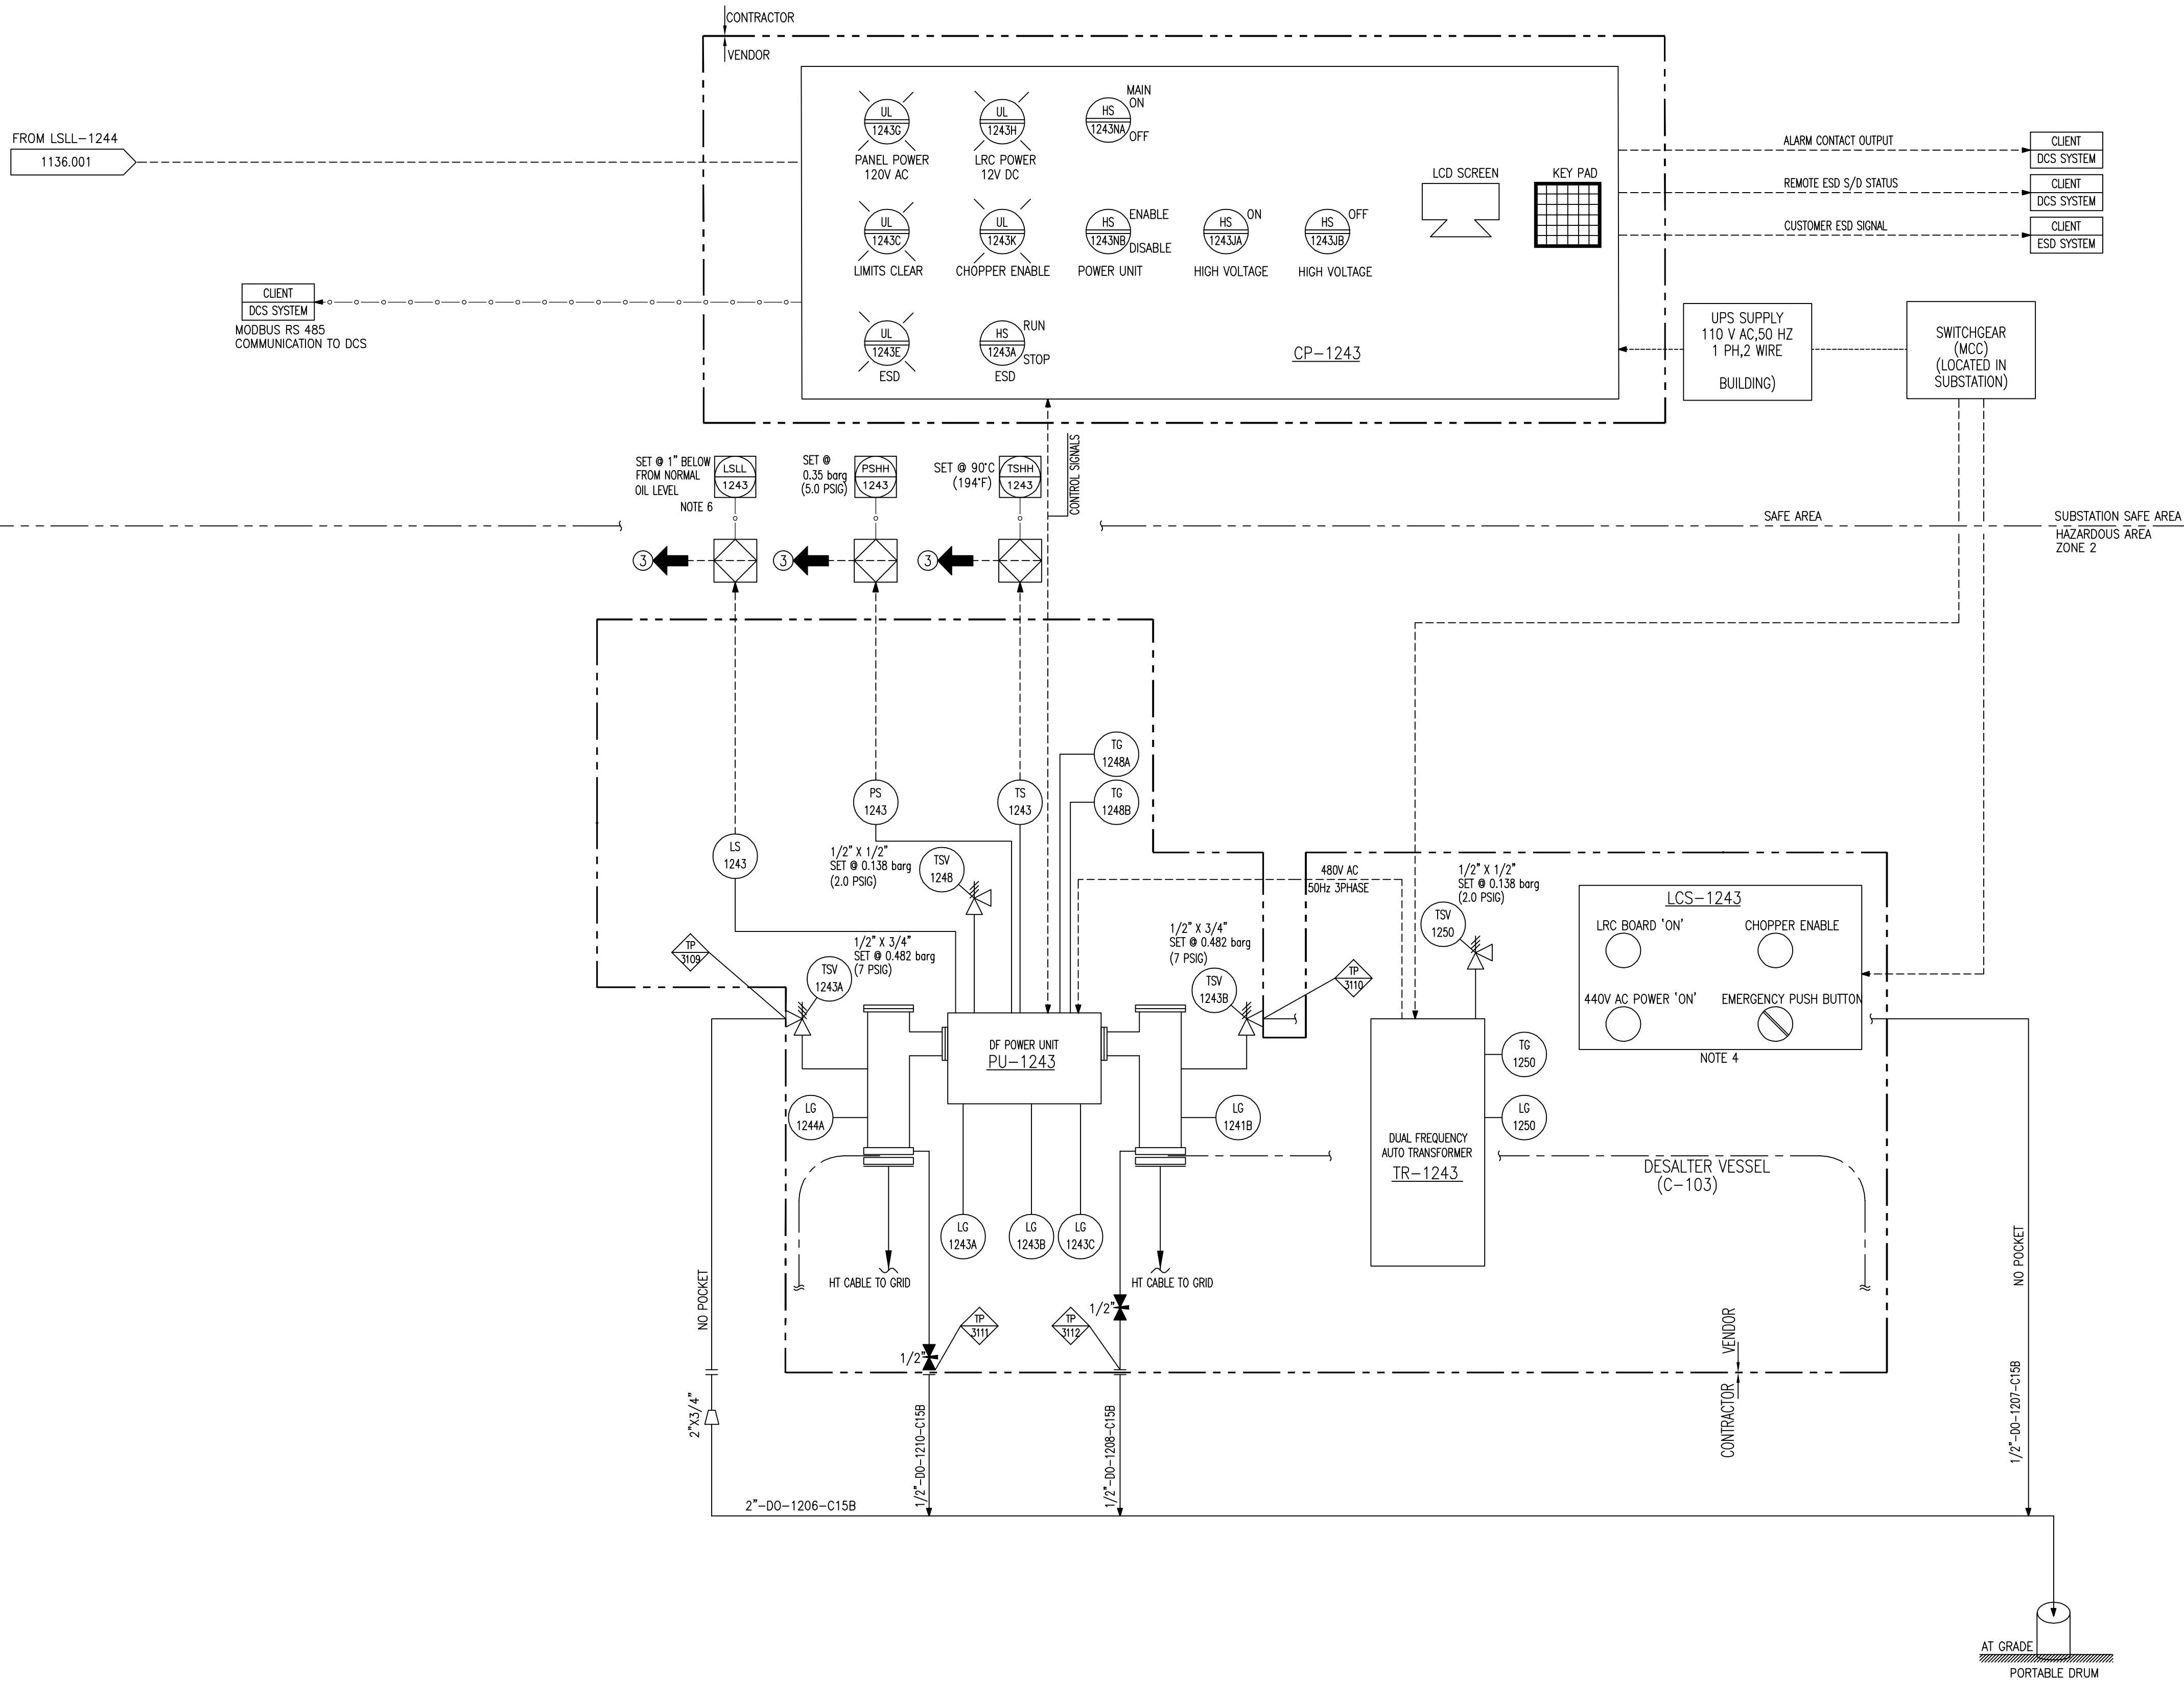

## GENERAL NOTES:

- FOR STANDARD SYMBOLS AND NOMENCLATURE SEE DRAWINGS 50489-530-020-PID-1104.001 & .002.
- ALL EQUIPMENT NUMBERS SHOWN ON THIS P&ID ARE PRECEDED BY 530-.
- ALL INSTRUMENT NUMBERS SHOWN ON THIS P&ID ARE PRECEDED BY 030-.
- FOR TYPICAL INSTRUMENT CONNECTION SBDV, XV, MOV & ESDV DETAILS SEE DRAWINGS 50489-530-020-PID-1106.001, .002, .003, .004, .005, .006 & .007.
- FOR MISCELLANEOUS PIPING TYPICAL VALVING, DRAINAGE & GENERAL ARRANGEMENT OF LEVEL INSTRUMENTS, PUMPS, STRAINERS & CONTROL VALVES SEE DRAWINGS 50489-530-020-PID-1108.001 TO 1108.010.
- DRAWING NUMBERS SHOWN IN P&ID CONTINUATION BOXES ARE ABBREVIATED SHOWING DRAWING SEQUENTIAL NUMBERS ONLY. THE FULL FORM OF THE DRAWING NUMBER IS 50489-530-020-PID-XXXX.SHT.NO.
- FOR MATERIAL SELECTION DIAGRAM SEE DRAWINGS 50489-530-020-MSD-1001.001 TO 1023.
- DETAIL NUMBERING FOR CI, SC, CC & CP SEE DRAWING 50489-530-020-PID-1108.003.
- PAINTING & COATING ARE IN ACCORDANCE WITH KOC-P-001.
- LOW POINT DRAIN & HIGH POINT VENT ARE INDICATED IN P&ID.
- FOR CAUSE & EFFECT REFER DOC. NO. 50489-530-020-PHL-1009.
- FOR ALARM VALUES REFER DOC. NO. 50489-530-020-SUM-1006.

## NOTES:

- DELETED
- DELETED
- DELETED
- EACH DUAL FREQUENCY DESALTER IS PROVIDED WITH LCS (LOCAL CONTROL STATION) IN THE FIELD FOR FOLLOWING:
  - LRC BOARD 'ON' (INDICATION)
  - CHOPPER ENABLE (INDICATION)
  - 440V AC POWER 'ON' (INDICATION)
  - EMERGENCY PUSH BUTTON
- TSV MOUNTED ON THE POWER UNIT IS PIPED TO AN OPEN DRAIN.
- THERE ARE THREE INTERNAL LIQUID LEVEL SWITCHES IN POWER UNIT (ONE IN EACH TANK) WHICH ARE WIRED IN SERIES TO A COMMON TERMINAL IN THE JUNCTION BOX.
- VENDOR REFERENCE DOCUMENT/DRAWING IS AS FOLLOWS:  
DESALTER P&ID-(50489-530-020-07226-PID-V004).  
POWER UNIT DATA SHEET-(50489-530-070-07226-DAT-V001).  
AUTO TRANSFORMER DATA SHEET-(50489-530-070-07226-DAT-V002).  
INSTRUMENT CABLE BLOCK DIAGRAM-(50489-530-080-07226-BLD-V001).  
CAUSE & EFFECT DIAGRAM-(50489-530-020-07226-CAE-V001).
- DELETED
- TYPE OF FLUID IN TRANSFORMER: CROSS 206 MINERAL OIL (NON-PCB).
- LIST OF ABBREVIATION  
DF : DUAL FREQUENCY  
HT : HIGH TENSION  
CP : DF LRC II PANEL  
LCS : LOCAL CONTROL SWITCH  
LRC : LOAD RESPONSIVE CONTROLLER  
TR : DF AUTO TRANSFORMER  
PCB : POLYCHLORINATED & BI-PHENYL  
PU : POWER UNIT

AS-BUILT
KOC APPROVAL
NAME / KOC No:
DESIGNATION :
GROUP / TEAM :
SIGNATURE :
DATE :

AS-BUILT
LARSEN & TOUBRO LIMITED
NAME : VAIBHAV VERMA
DESIGNATION : AGM
SIGNATURE :
DATE : 01-Sep-2018
DEPT/ DIVISION : ENGINEERING

REV.	DESCRIPTION	DRAWN	CHECKED	HOD	PEM	DATE
ZO	ISSUED FOR AS-BUILT	HSB/SSI	AKG	SRA	DER	01.09.18
01	ISSUED FOR CONSTRUCTION	HSB/SSI	AKG	SRA	DER	27.12.16
0	ISSUED FOR CONSTRUCTION	PAK/PRS	AKG	SRA	RAK	09.06.16
B	ISSUED INCORPORATED CLIENT COMMENTS	PAK/ABY	AKG	SRA	RAK	14.12.16
A	ISSUED FOR APPROVAL	JSI/VA	AKG	SRA	RAK	09.09.15

## CONTRACTOR REVISION

<b>KUWAIT OIL CO.</b> K. S. C.	<b>شركة نفط الكويت</b> ش.م.ك.
-----------------------------------	----------------------------------

CONTRACTOR DETAILS:-
<b>LARSEN &amp; TOUBRO LIMITED</b> FARIDABAD

PROJECT TITLE:-
NEW GATHERING CENTRE GC-30 IN NORTH KUWAIT

DOCUMENT TITLE:-
PIPING & INSTRUMENTATION DIAGRAM SECOND STAGE DESALTER POWER UNIT TRAIN-A (530-C-103)

PROJECT NO.	DRAWING NO.
CONTRACTOR DRG. NO.	REV. KOC DRG. NO.
50489-530-020-PID-1136.003	ZO
SHEET NO. 3 OF 4	SHEET NO.
COMPANY DRG. NO.	REV.
SHEET NO.	