


AREA PROTECTED	NO. OF NOZZLES	K FACTOR	SPRAY ANGLE	TRIGGER HEADS	LINE No. 1	LINE No. 2	LINE No. 3	LINE No. 4	LINE No. 9	LINE NO. 10	LINE NO. 11	TAG A	TAG B	TAG C	TAG D	TAG E	TAG F	TAG G	TAG H	TAG I	TAG J	TAG K	TAG L	TAG M	TAG N	TAG O	TAG AA	DV SKID NO.	SUCTION COLLECTION HEAD NO.
530-G-101 A/B/C	06	35	140°	06	3"-WF-9196-Q35A	2"-WF-9197-Q35A	3"-WF-9198-Q15A	3"-WF-9199-Q15A	3"-WF-9204-Q35A	1"-AI-1769-S10A	1/2"-AI-9046-S10A	9010A	9010B	9010C	9010D	9010E	9010F	9010G	9010H	9010I	9010J	9010K	9010L	9010M	9010N	9010O	SP-047	DVS-19	SCH-23
530-G-201 A/B/C	06	35	140°	06	3"-WF-9213-Q35A	2"-WF-9206-Q35A	3"-WF-9207-Q15A	3"-WF-9208-Q15A	3"-WF-9205-Q35A	1"-AI-1770-S10A	1/2"-AI-9047-S10A	9011A	9011B	9011C	9011D	9011E	9011F	9011G	9011H	9011I	9011J	9011K	9011L	9011M	9011N	9011O	SP-048	DVS-20	SCH-24

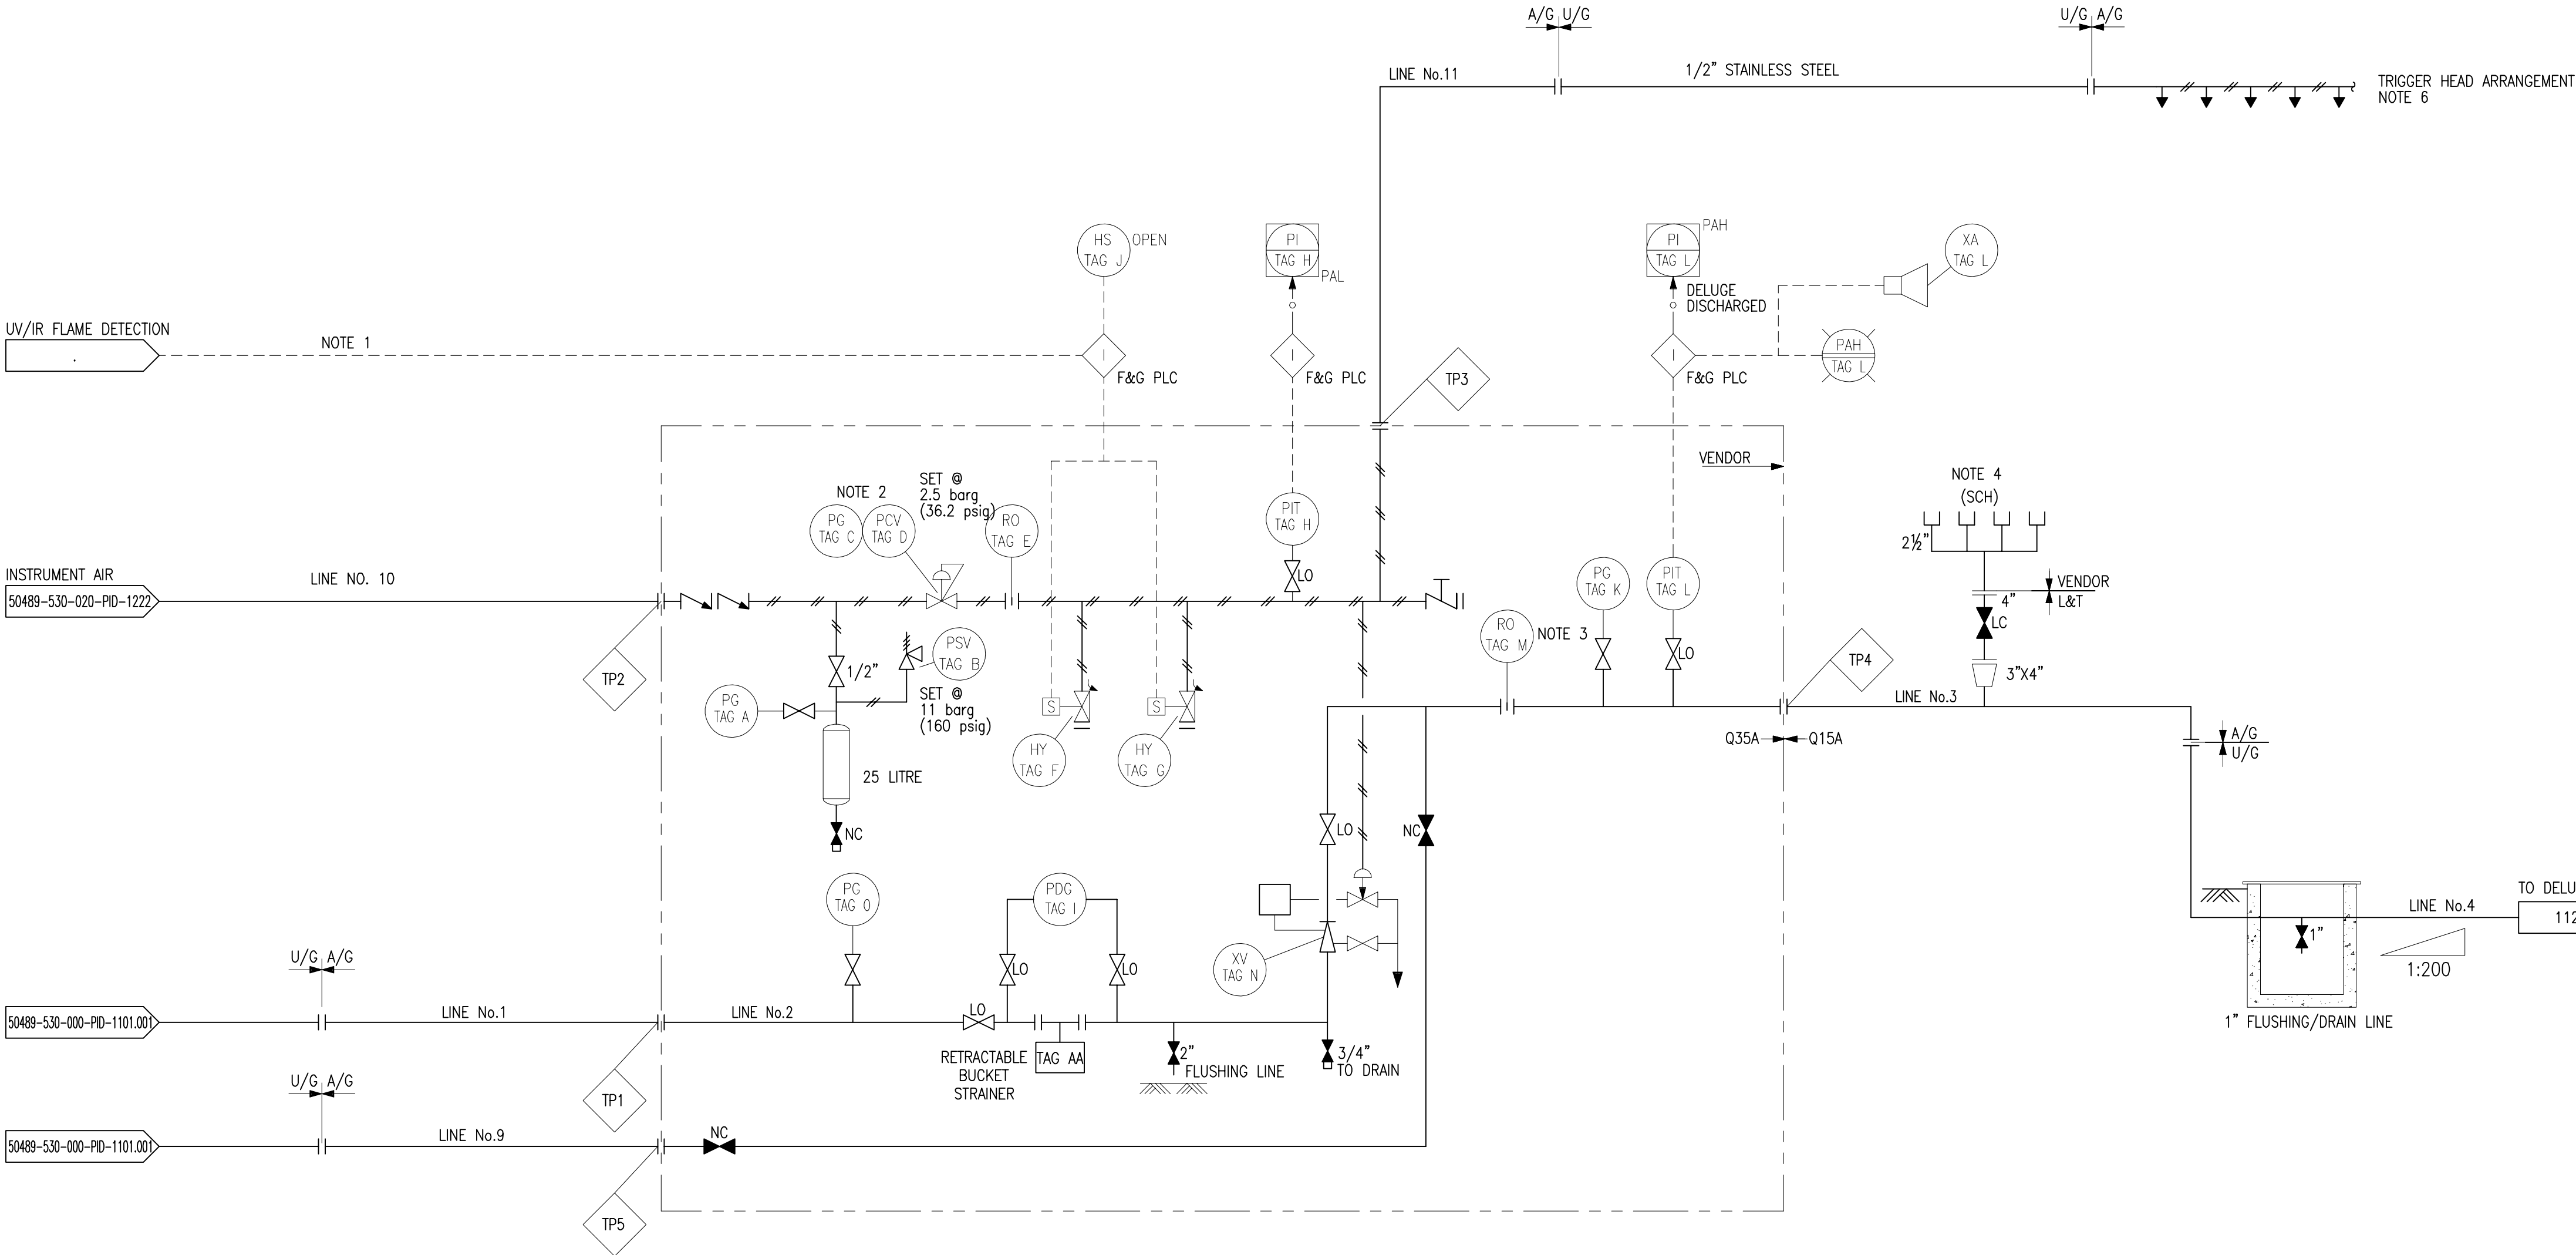

TYPICAL SKID OF DELUGE VALVE FOR DESALTER FEED PUMPS (530-G-101A/B/C & 530-G-201A/B/C)

AS-BUILT	
KOC APPROVAL	
NAME / KOC No:	
DESIGNATION :	
GROUP / TEAM :	
SIGNATURE :	
DATE :	

AS-BUILT	
LARSEN & TOUBRO LIMITED	
NAME : VAIBHAV VERMA	
DESIGNATION : AGM	
SIGNATURE :	
DATE : 12-Aug-2018	
DEPT/ DIVISION : ENGINEERING	

GENERAL NOTES:

- FOR STANDARD SYMBOLS AND NOMENCLATURE SEE DRAWINGS 50489-530-020-PID-1104.001 & 1105.001.
 - ALL EQUIPMENT NUMBERS SHOWN ON THIS P&ID ARE PRECEDED BY 530-
 - FOR ESDV, SBDV AND MOV DETAILS SEE DRAWINGS 50489-530-020-PID-1106.001 & 1107.001.
 - FOR MISCELLANEOUS PIPING DETAILS SEE DRAWINGS 50489-530-020-PID-1108.001.
 - FOR TYPICAL VALVING, DRAINAGE AND GENERAL ARRANGEMENT OF LEVEL INSTRUMENTATION, PUMPS AND CONTROL VALVES SEE DRAWING 50489-530-020-PID-1109.001.
- NOTES:**
- UV/IR FLAME DETECTORS AUTOMATICALLY DETECT FIRE AND WHEN ACTIVATED A SIGNAL IS SENT TO THE F&G PANEL IN THECCR.
 - AIR SET IS FITTED WITH AIR FILTER, REGULATOR AND PI.
 - RO SUPPLIED TO GIVE PRESSURE/LOSS CHARACTERISTICS OF THE DELUGE VALVE.
 - 4 WAY SUCTION COLLECTION HEAD IS INSTALLED TO ALLOW SECONDARY SUPPLY OF WATER TO DELUGE SYSTEM.
 - DELUGE VALVE IS DIAPHRAGM TYPE DESIGNED FOR DELUGE OPERATION AND BE UL LISTED AND FM APPROVED
 - TRIGGER HEAD CONFIGURATION
1/2" FUSABLE PLUGS OVER PROTECTED EQUIPMENT ON A GENERAL 3 x 3 METRE MATRIX
 - 2 VALVES REQUIRED IN BYPASS LINE TO PREVENT UNNECESSARY LOSS OF WATER DUE TO GATE VALVE PASSING.
 - ADEQUATE DRAINAGE IS PROVIDED AROUND DELUGE SYSTEM TO AVOID ACCUMULATION OF WATER AROUND THE EQUIPMENT
 - PROVISION ARE MADE FOR PRESSURE TESTING AS PER NFPA 15 CLAUSE NO. 6.4.4 & 6.4.5 NEAR THE HYDRAULICAL REMOTEST NOZZLE.
 - DELUGE VALVES SHALL BE HELD CLOSED BY AIR PRESSURE SUPPLIED FROM THE INSTRUMENT AIR SYSTEM.
 - DELUGE VALVES SHALL FULLY OPEN WITHIN 10 SECONDS ON REMOVE OF INSTRUMENT AIR BY:
A. REMOTE OPERATION OF A PUSH BUTTON AT THE MAIN FIRE AND GAS PENEL, LOCATED IN THE CONTROL ROOM, TO ENERGIZE A SOLENOID VALVES IN INSTRUMENT AIR SUPPLY TO DELUGE VALVE.
 - LOCAL OPERATION OF A MECHANICAL AIR RELEASE UNIT OF DELUGE VALVE STATION.
 - SPRAY NOZZLE IS CONSTRUCTED FROM MAINE BRASS.
 - DELUGE VALVE STATIONS ARE PROTECTED FROM RADIATED HEAT BY THE PROVISION OF METAL RADIATION SHIELDS.
 - PIPE MOC (AS PER KOC-L-009):
3" SIZE AND BELOW : 90-10 COPPER NIKEL TO ASTM B 466 UNS.
4" SIZE AND ABOVE : CARBON STEEL API 5L GRB WITH PHENOLIC EPOXY COATING.
 - FLANGE INSULATION KITS ARE PROVIDED AT DISSIMILAR METAL JUNCTIONS HAVING ELECTROMOTIVE POTENTIAL DIFFERENCE GREATER THAN 0.05V AS PER CLAUSE 7.3.1.17 OF KOC-L-009.
 - INTERNALLY COATED UG PIPING ARE FLANGED SPOOLS AS PER KOC-L-009.
 - FLUSHING DRAIN PIT IS ACCESSIBLE FROM GROUND LEVEL.
 - THE UNDERGROUND SECTION ARE EXTERNALLY COATED WITH 3 LAYERS EXTRDED HDPE AS PERKOC-P004 PART 6, REV-2 WITH THE INTERNAL PHENOLIC EPOXY ON THE PIPING SHALL BE AS PER KOC-P-005 REV-1.
 - THE ABOVE GROUND PIPING SECTION ARE COATED WITH SYSTEM A1-1 OF KOC-P-001 REV 3
 - TOP CHAMBER OF DELUGE VALVE IS CONNECTED TO WATER LINE & TO WATER INLET OF ACTUATOR WHEN THE AIR PRESSURE DROPS DUE TO DETECTION OF FIRE THE DIAPHRAGM OF ACTUATOR IS LIFTED AND ALLOWS THE WATER PRESSURIZING DIAPHRAM OF DELUGE VALVE TOP CHAMBER TO DRAIN. THIS RELEASES THE PRESSURE IN THE TOP CHAMBER OF DELUGE VALVE ALLOWING THE DELUGE VALVE TO OPEN.

LEGENDS:

SYMBOL	DESCRIPTION
	FIRE WATER PIPING
	SPRAY NOZZLE
	REDUCER
	GATE VALVE
	END CAP

REFERENCE DRAWINGS:

50489-530-000-CAL-1011	HYDRAULIC CALCULATION FOR WATER SPRAY SYSTEM FOR DESALTER FEED PUMPS TRAIN A & TRAIN B
KOC-L-009	KOC STANDARD FOR FIRE PROTECTION SYSTEMS
50489-530-000-LAD-1065	FIRE WATER NETWORK LAYOUT

REV.	DESCRIPTION	DRAWN	CHECKED	HOD	PEM	DATE
ZO	ISSUED FOR AS-BUILT	PAK/DEU	NJ	SRA	RAK	12.08.18
01	RE-ISSUED FOR CONSTRUCTION	PAK/DEU	NJ	SRA	RAK	27.07.16
0	ISSUED FOR CONSTRUCTION	PAK/DEU	NJ	SRA	RAK	13.05.16
A	ISSUED FOR APPROVAL	PAK/DEU	NJ	SRA	RAK	15.10.15

CONTRACTOR REVISION



CONTRACTOR DETAILS:-
LARSEN & TOUBRO LIMITED
FARIDABAD

PROJECT TITLE:-
NEW GATHERING
CENTRE GC-30 IN NORTH KUWAIT

DOCUMENT TITLE:-
PIPING & INSTRUMENTATION DIAGRAM
FIRE WATER SPRAY SYSTEM FOR DESALTER
FEED PUMPS TRAIN A & TRAIN B

PROJECT NO.	DRAWING NO.
EF1902	50489-530-000-PID-1123.001
CONTRACTOR DRG. NO.	REV. KOC DRG. NO.
SHEET NO. 1 OF 2	ZO
COMPANY DRG. NO.	REV.
SHEET NO.	