


AS SHOWN IN P&ID

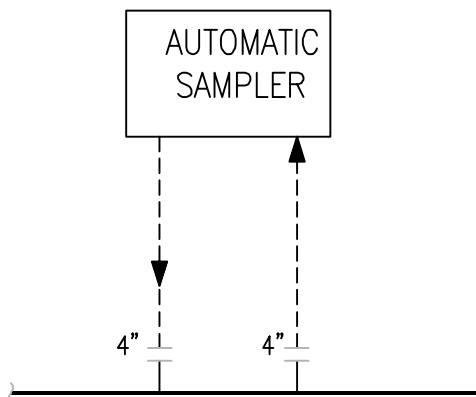

DETAIL OF SAMPLE CONNECTION

FOR AUTOMATIC SAMPLER DETAIL
REFER PID:
50489-530-020-1275.001/.002
50489-530-020-1276.001/.002
50489-530-020-1277.001/.002

GENERAL NOTES:

- A. FOR STANDARD SYMBOLS AND NOMENCLATURE SEE DRAWINGS 50489-530-020-PID-1104.001 & 1104.002.
B. ALL EQUIPMENT NUMBERS SHOWN ON THIS P&ID ARE PRECEDED BY 530-




NOTES:

- DELETED
- DELETED
- DELETED.
- LIQUID SEAL
- VALVES ADJACENT TO SAMPLE CABINET.
- USED FOR SAMPLING AT DESALTER VESSELS AND THEIR INLET/OUTLET LINES.
- ALL SAMPLING CONNECTIONS ARE ACCESSIBLE AT GRADE.
- FIRST DRAIN ISOLATION VALVE ARE FITTING TO FITTING (MINIMUM DISTANCE) FROM HEADER OR PIPE TO REDUCE DEAD LEG CORROSION.
- DELETED.
- DELETED.
- VENT TO SAFE LOCATION AS PER KOC-G-002.
- DELETED.
- FOR SAMPLE INLET, DRAIN AND VENT LINE NUMBER, REFEER PID: 1108.013/.014

AS-BUILT
KOC APPROVAL
NAME / KOC No:
DESIGNATION :
GROUP / TEAM :
SIGNATURE :
DATE :

AS-BUILT
LARSEN & TOUBRO LIMITED
NAME : VAIBHAV VERMA
DESIGNATION : AGM
SIGNATURE :
DATE : 05-Aug-2018
DEPT/ DIVISON : ENGINEERING

SC-J STREAM : (NOTE 6)

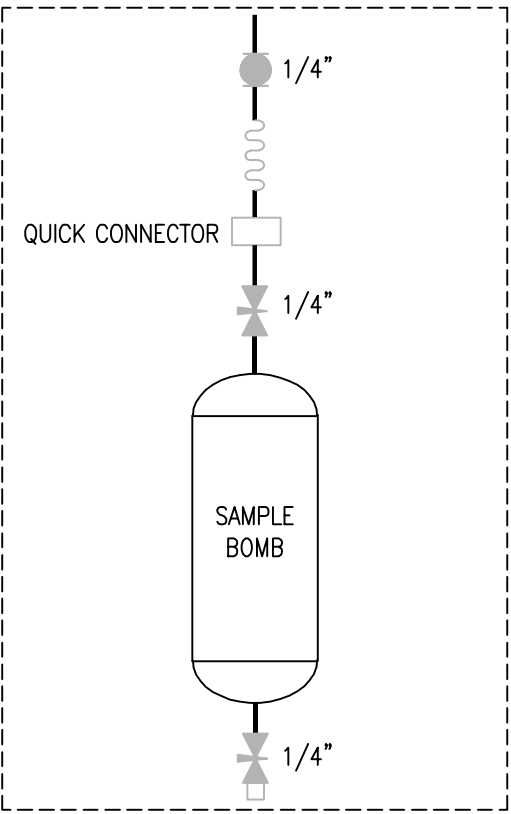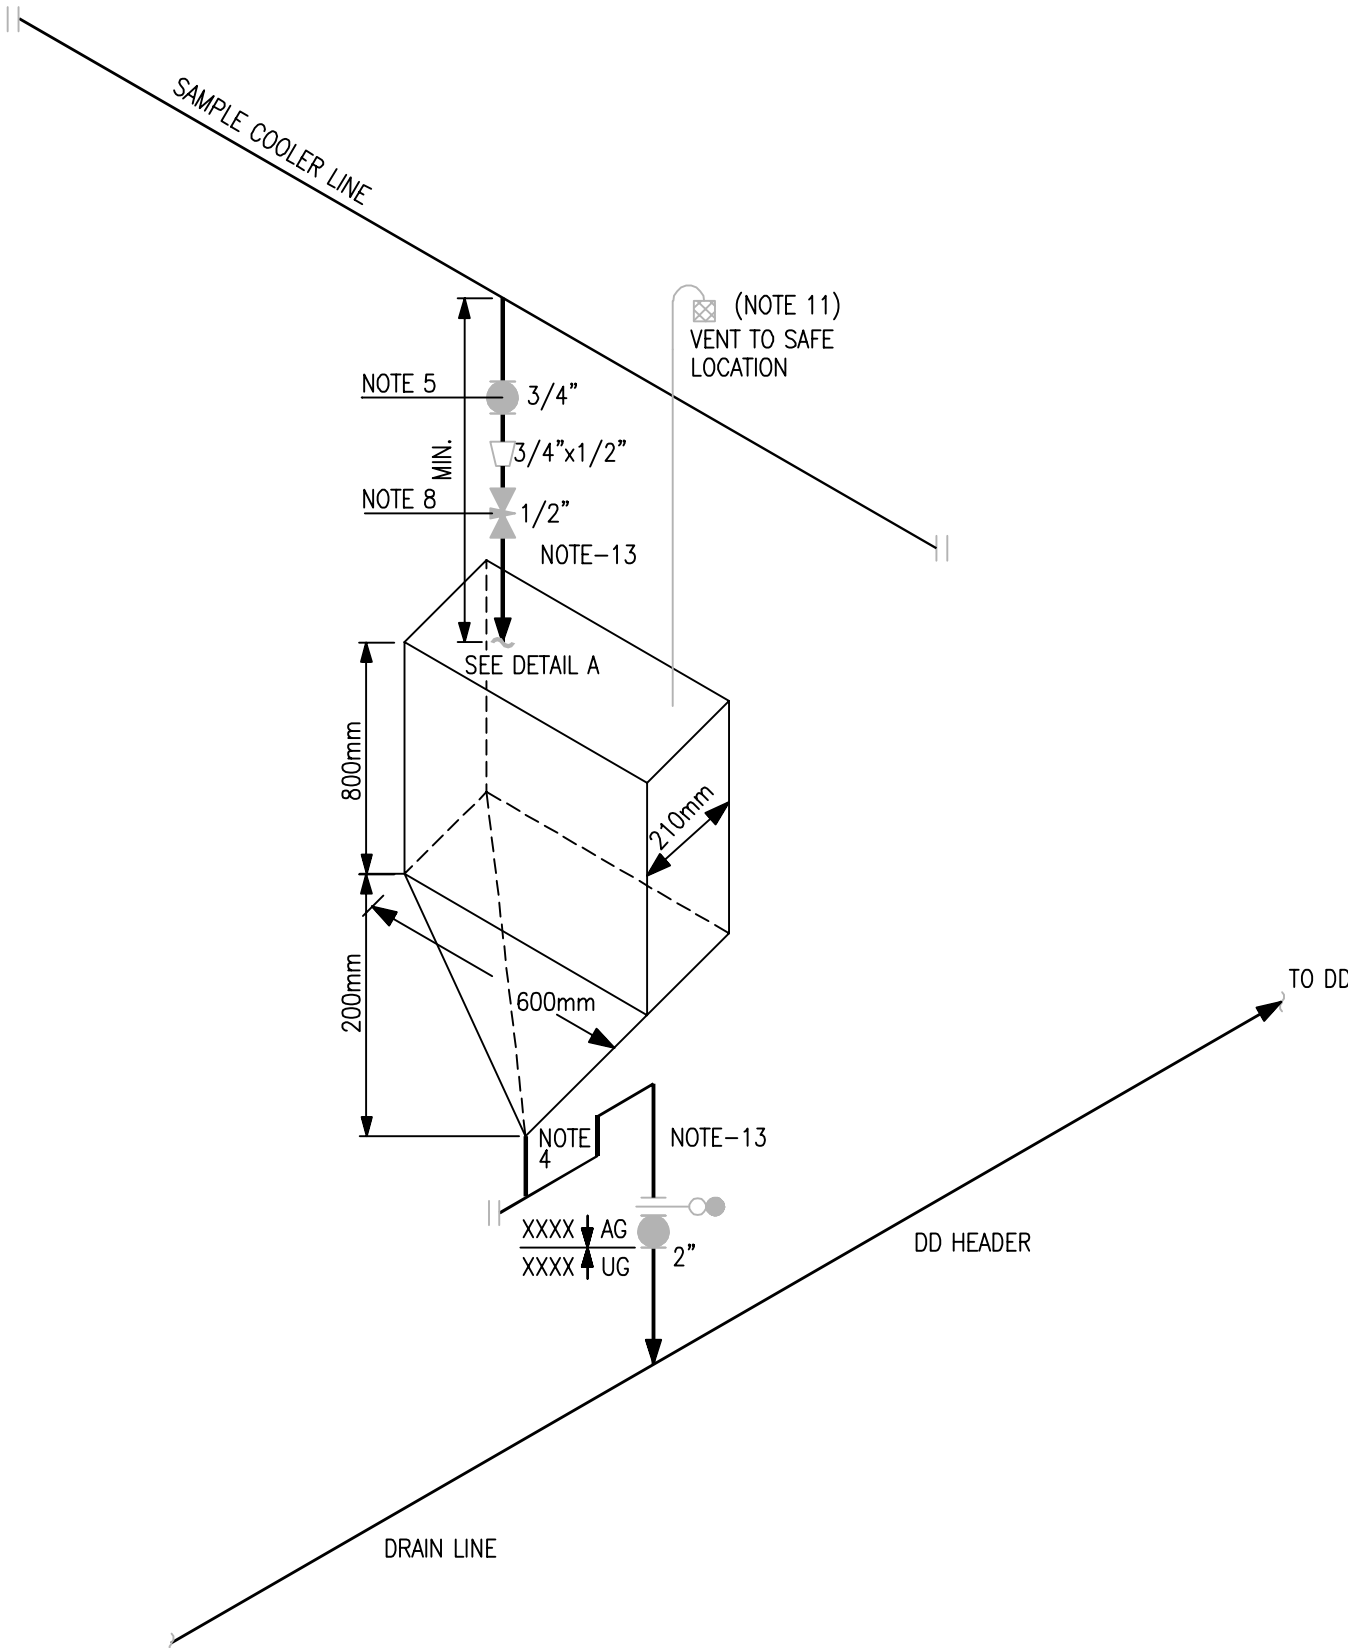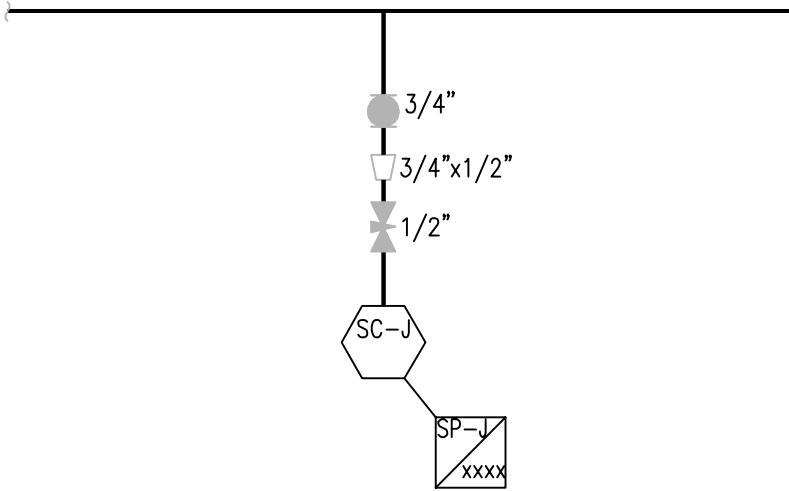

ZO	ISSUED FOR AS-BUILT	HSB/ABY	AKG	SRA	RAK	05.08.18
O	ISSUED FOR CONSTRUCTION	HSB/ABY	AKG	SRA	RAK	20.07.16
E	ISSUED INCORPORATED CLIENT COMMENTS	PAK/ABY	AKG	SRA	RAK	19.04.16
D	ISSUED INCORPORATED CLIENT COMMENTS	BAK/ABY	AKG	SRA	RAK	31.12.15
C	ISSUED INCORPORATED CLIENT COMMENTS	BAK/ABY	AKG	SRA	RAK	28.10.15
OC	ISSUED INCORPORATED CLIENT COMMENTS	BAK/ABY	AKG	SRA	RAK	08.09.15
B	ISSUED"INCORPORATED CLIENT COMMENTS"	JSI/VSA	AKG	SRA	RAK	20.01.15
A	ISSUED FOR APPROVAL	JSI/VSA	AKG	SRA	RAK	24.11.14
REV.	DESCRIPTION	DRAWN	CHECKED	HOD	PEM	DATE
				APPRD.		

CONTRACTOR REVISION



CONTRACTOR DETAILS:-
LARSEN & TOUBRO LIMITED
FARIDABAD

PROJECT TITLE:-
NEW GATHERING CENTRE GC-30
IN NORTH KUWAIT

DOCUMENT TITLE:-
PIPING & INSTRUMENTATION DIAGRAM
STANDARD DRAWING (SAMPLER SYSTEM)

PROJECT NO.	DRAWING NO.
CONTRACTOR DRG. NO.	REV. KOC DRG. NO.
50489-530-020-PID-1108.002	Z0
SHEET NO. 2 OF 10	SHEET NO.
COMPANY DRG. NO.	REV.
EF1902-530-DCO-PID-0108.002	A2
SHEET NO.	